N —
B & CD

Retracing and Resurvey

Township. N° 28. N. Range N° 3 W. Mer. Mich.

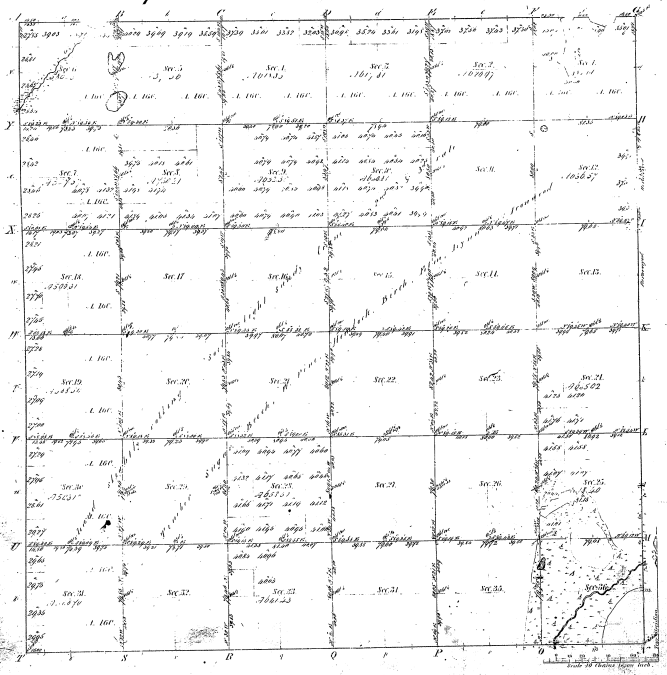

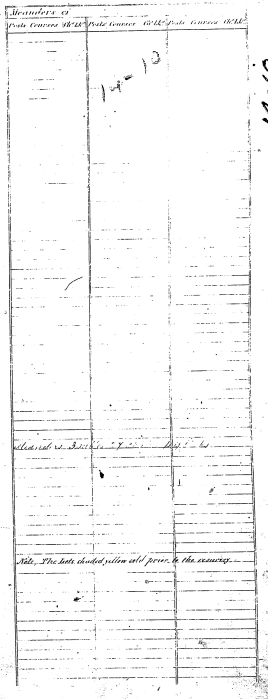

14-10

Total number of Acres 97[illegible]37

Surveys Designated	By Whom surveyed	Date of Contract	Amount of Surveys	When Surveyed	When Returned
Township lines	A.D. Mudbell	Mch 28th 1839	[illegible]	2d Quar. 1839	
Subdivisions	Walter Warner	August 1st 1845	2 — 00 — 00	3d Quar. 1847	

The above Map of Township, N° 28 North of Range N° 3 West of the Principal Meridian of the Territory of Michigan is strictly conformable to the field notes of the survey thereof on file in this office, and is hereby approved and accepted.

Surveyor Generals Office
Detroit October 6th 1851

C. C. Comstock
Surveyor General