Township No. 38 N. Range No. 22 W. Mer. Mich

LITTLE BAY DE-NOC.

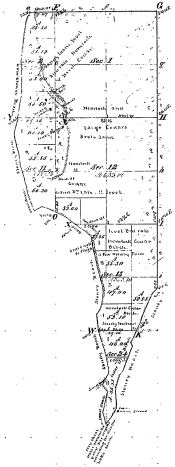

LAKE MICIGAN.

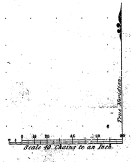

Meanders of								
Posts	Courses	Ch^s Lk^s	Posts	Courses	Ch^s Lk^s	Posts	Courses	Ch^s Lk^s

46-35

Total number of Acres 1647.80

Survey Designated	By Whom Surveyed	Date of Contract	Amount of Survey M. Ch^s Lk^s	When Surveyed	When Charged in the Surv^r Genl's acc^t
Township Lines	[illegible]			[illegible]	
	[illegible]	July 10 1846	2 00	[illegible] 1847	
Subdivisions	[illegible]	July 10 1846	1112 26	[illegible] 1846	
Meanders Sec^s			1 23 13	[illegible] 1847	

The above Map of Township No. 38 North of Range No. 22 W. of the Principal Meridian Michigan is strictly conformable to the field notes of the survey thereof on file in this Office, which have been examined and approved.

Surveyor General's Office
Date March 2 1847

Lucius Lyon, Sur^r Genl.

46-35