Township N.° 39 N Range N.° 24 W Mer.

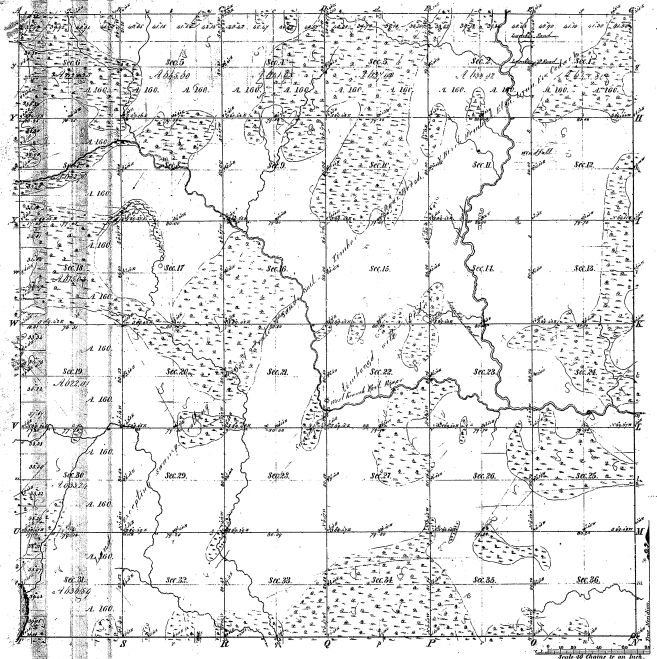

Meanders of							
Poste	Courses	Var. E.	Poste	Courses	Var. E.	Poste	Courses	Var. E.

46-25

Total number of Acres 22976.06

Surveys Designated	By Whom Surveyed	Date of Contract	Amount of Surveys	When Surveyed	When Approved and Rec.d in the Surv.r Gen.l Office
			M. Chs. Lks.		
Meanders	Milton	1st Oct.r 1824	1 00 00	2nd Quar.r 1825	
Subdivisions	Geo. R. Adair	Nov.r 2 July 2 1832	309 76 00	2nd Quar.r 1852	
Exterior Boundary	John Dent	7th Dec.r 1854	6 00 60	2nd Quar.r 1855	

The above Map of Township 39 N. of the Base of Range 24 W. of the Principal Meridian Michigan is strictly conformable to the field notes of the Survey thereof on file in this Office, which have been examined and approved.

Surveyor Generals Office
Detroit July 16 1862

Seneca Chapman
Surv.r Gen.l