6-38

Township N.I north, Range N.VI west (Mich. Ter.)

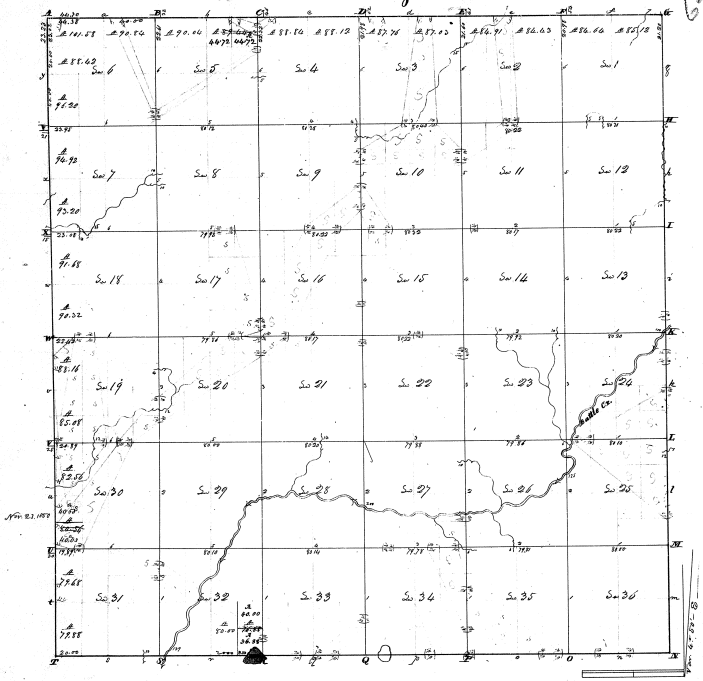

Mr N E 1	85	12	Ex 19	320	
Sx " "	80		Ex N W "	80	4
Mr N W "	84	64	Mr " "	88	16
Sx " "	80		Ex S W "	80	
Sx " "	320		Mr " "	85	08
Mr N E 2	84	43	Sec 20	640	
Sx " "	80		21	640	
Mr N W "	84	91	22	640	
Sx " "	80		23	640	
Sx " "	320		24	640	
Mr N E 3	87	03	25	640	
Sx " "	80		26	640	
Mr N W "	87	76	27	640	
Sx " "	80		28	640	
Sx " "	320		29	640	
Mr N E 4	88	12	Ex 30	320	
Sx " "	80		Ex N W "	80	
Mr N W "	88	84	Mr " "	82	56
Sx " "	80		Ex S W "	80	
Sx " "	320		Mr " "	80	56
Mr N E 5	89	44	Ex 31	320	
Sx " "	80		Ex N W "	80	
Mr N W "	90	04	Mr " "	79	68
Sx " "	80		Ex S W "	80	
Sx " "	320		Mr " "	79	88
Mr N E 6	90	84	Mr 32	320	
Sx " "	80		Ex S E "	76	88
Mr N W "	101	58	Mr " "	80	
Sx " "	88	42	S W "	160	
S E "	160		Sec 33	640	
Ex S W "	80		34	640	
Mr " "	96	20	35	640	
Ex 7	320		36	640	
Ex N W "	80		11532	80	
Mr " "	94	92	11697	39	
Ex S W "	80		23230	19	Total
Mr " "	93	20			
Sec 8	640				
9	640				
10	640				
11	640				
12	640				
13	640				
14	640				
15	640				
16	640				
17	640				
Ex 18	320				
Ex N W "	80				
Mr " "	91	68			
Ex S W "	80				
Mr " "	90	32			
	11697	39			

Surveyed in April 1826 by Musgrove Evans D.S.

Edward Tiffin Surv. Gen.