


Township N. III north, Range N. III west (Civil Town)

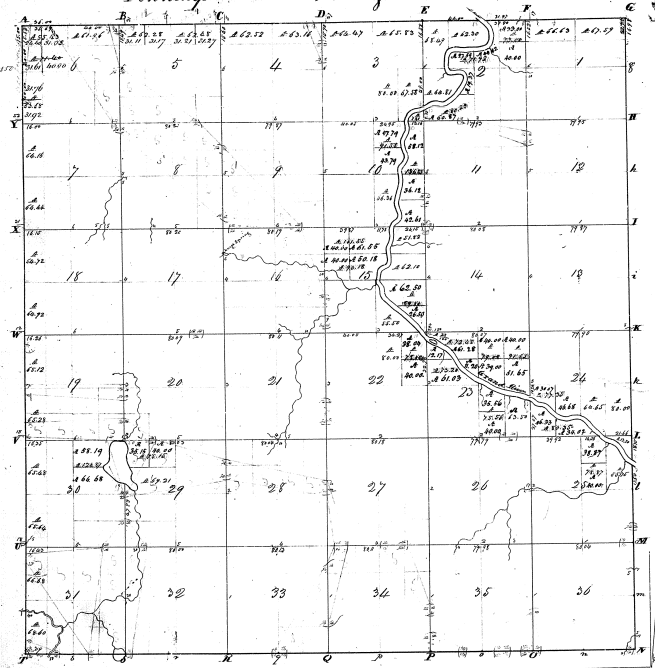

Surveyed on January 1887 by Augustus Evans

Scale 6024 2' and 1/2 inch = 1 mile

E 3 31

15-31


