Township No. 37 N. Range No. 7 W. Mer.

19-12

Meanders of Lake Michigan.									
Posts	Courses	Ch. & Lks.	Posts	Courses	Ch. & Lks.	Posts	Courses	Ch. & Lks.
1	N 5 E	22.00						
	N 20 W	11.00						
	N 15 E	30.00						
2	N 10 W	18.20						
	N 13 W	12.00						
	North	13.50						
3	N 12 E	15.20						
	N 2 E	12.00						
4	N 16 E	29.20						
	N 30 E	22.00						
	N 45 E	23.00						
	N 40 E	17.00						
	N 20 E	35.00						
5	N 43 E	13.50						
6	N 30 E	32.40						

19-12

L. MICHIGAN.

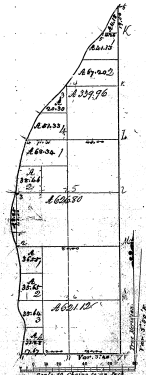

Total number of Acres 1807.31

Survey Designated.	By Whom Surveyed.	Date of Contract.	Amount of Surveys M. Ch. Lks.	When Surveyed.	When Charged in the Surv. Genl's acct.
Township lines.	John Millette	Jan. 15. 1840	4 17 17	2d qr 1840	3d qr 1840
Subdivisions.	Same	Aug. 11	6 08 57	4th	4th

The above Map of Township No. 37 N. of Range No. 7 W. of the Principal Meridian Michigan, is strictly conformable to the field notes of the survey thereof on the Surveys Office, which have been examined and approved.

Surveys General's Office
Cincinnati Feb. 2. 1841.

S. S. Gaines Surv. Genl.