


TOWNSHIP No. 39 NORTH, RANGE No. 5 WEST, MICHIGAN MERIDIAN, MICHIGAN.
DEPENDENT RESURVEY AND EXTENSION SURVEY, SECTIONS 23 AND 26.

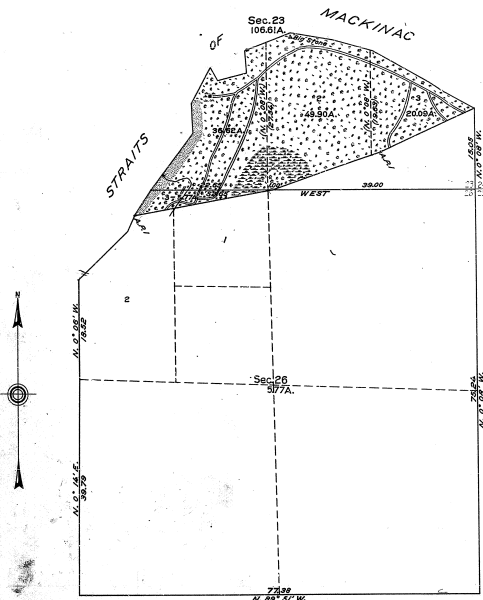

AREA RESURVEYED, 639.80 ACRES.
AREA SURVEYED, 112.38 ACRES.

LINES DESIGNATED BY WHOM SURVEYED		GROUP NO.	MILEAGE		WHEN SURVEYED			
			NO.	DATE	MLS.	CHS.	BEGUN	COMPLETED
SUBDIVISIONAL	GUY R. JEAL,	38	3	SEPT. 20,	48.63	1935.	OCT. 5,	OCT. 14,
MEANDER	U.S.C. ENGINEER.		2	1935.	18.92	1935.	1935.	

MEMORANDUM.

THIS PLAT DELINEATES A RETRACEMENT AND REESTABLISHMENT OF THE LINES DEFINING LANDS IN SECTIONS 23 AND 26, TOWNSHIP 39 NORTH, RANGE 5 WEST, AS SHOWN UPON THE TOWNSHIP PLAT APPROVED FEBRUARY 12, 1841, IN THEIR TRUE ORIGINAL POSITIONS ACCORDING TO THE BEST AVAILABLE EVIDENCE OF THE POSITION OF THE ORIGINAL CORNERS, AND AN EXTENSION SURVEY INCLUDING LANDS WHICH WERE ERRONEOUSLY OMITTED FROM THE ORIGINAL SURVEY AND NOT SHOWN ON SAID PLAT.

THE POSITION OF THE ORIGINAL RECORD-MEANDER COURSES OF THE STRAITS OF MACKINAC IS SHOWN BY AN IRREGULAR LINE WITH NUMBERED ANGLE POINTS. THE MEANDER COURSES AS THUS ORIGINALLY REPORTED WERE GROSSLY IN ERROR, AND HAVE THEREFORE BEEN MARKED AS A FIXED BOUNDARY, WITH THE DIRECTIONS AND LENGTHS OF THE SEVERAL COURSES ADJUSTED TO THE RECORD OF THE ORIGINAL SURVEY.

THE SURVEY WAS EXECUTED PURSUANT TO AUTHORITY CONTAINED IN GENERAL LAND OFFICE LETTER 1568440 "M" DATED JUNE 21, 1935, WHICH BEARS DEPARTMENTAL APPROVAL UNDER DATE OF JULY 9, 1935.

OFFICE OF U.S. SUPERVISOR OF SURVEYS.
DENVER, COLORADO, MAY 15, 1936.

THE ABOVE PLAT OF SECTIONS 23 AND 26, TOWNSHIP NO. 39 NORTH, RANGE NO. 5 WEST OF THE MICHIGAN MERIDIAN, IN THE STATE OF MICHIGAN, IS STRICTLY CONFORMABLE TO THE FIELD NOTES OF THE SURVEY THEREOF, WHICH HAVE BEEN EXAMINED AND APPROVED.

William D. Dwyer
U.S. SUPERVISOR OF SURVEYS.

DEPARTMENT OF THE INTERIOR.
GENERAL LAND OFFICE.
WASHINGTON, D. C., JUNE 11, 1936.

THE SURVEY REPRESENTED BY THIS PLAT, HAVING BEEN CORRECTLY EXECUTED IN ACCORDANCE WITH THE REQUIREMENTS OF LAW AND THE REGULATIONS OF THIS OFFICE, IS HEREBY ACCEPTED.

Andrew H. Smith
ASSISTANT COMMISSIONER.