Resurvey.

Township No. 19 N. Range No. 2 E. Mer. Mich.

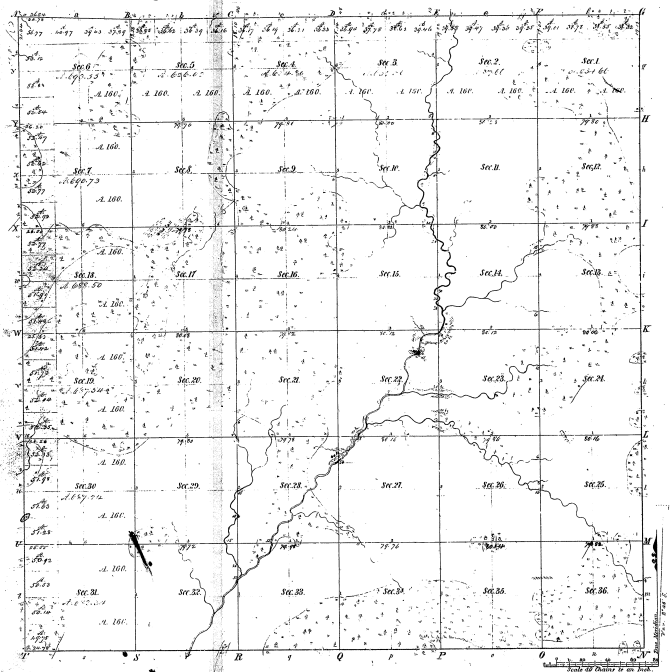

Meanders of								
Posts	Courses	Ch. Lks.	Posts	Courses	Ch. Lks.	Posts	Courses	Ch. Lks.

Total number of Acres. 23256.52

Surveys Designated	By Whom Surveyed	Date of Contract	Amount of Surveys	When Surveyed	When p.d for and ch.d in the Surv. Gen.l Ass.t
Township	Lewis Wilson	July 10th 1857	M. Ch. Lks.	3rd q.r 1857	
Subdivisions	John Mullett	Jany 10th 1846	60. 34. 36	2nd q.r 1846	

The above Map of Township No. 19 North of Range No. 2 East of the Principal Meridian Michigan is strictly conformable to the field notes of the survey thereof on file in this Office, which have been examined and approved.

Surveyor Generals Office
Detroit Jany 26, 1846

Lucius Lyon, Sur. Genl.

23-6

21

23-6

16