


Township N^o 45 N. Range N^o 43 W. Mer. Mich

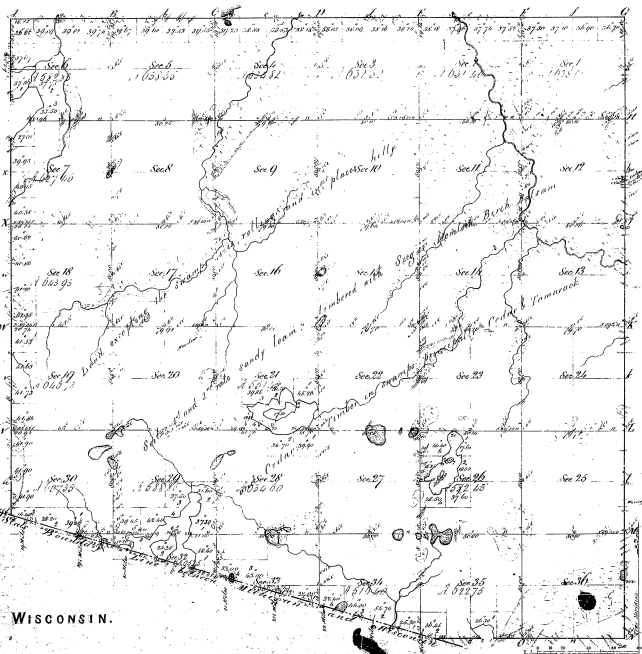

WISCONSIN.

Number of
Pine Acres 3142 Pine Acres 2142 Pine Acres 2142

42 = 36

42-36

Alvander
10 miles 68 Acres 15 Ponds

Total number of Acres 21,000.00


