Township No. 47 N. Range No. 44 W. Mer. Mich.

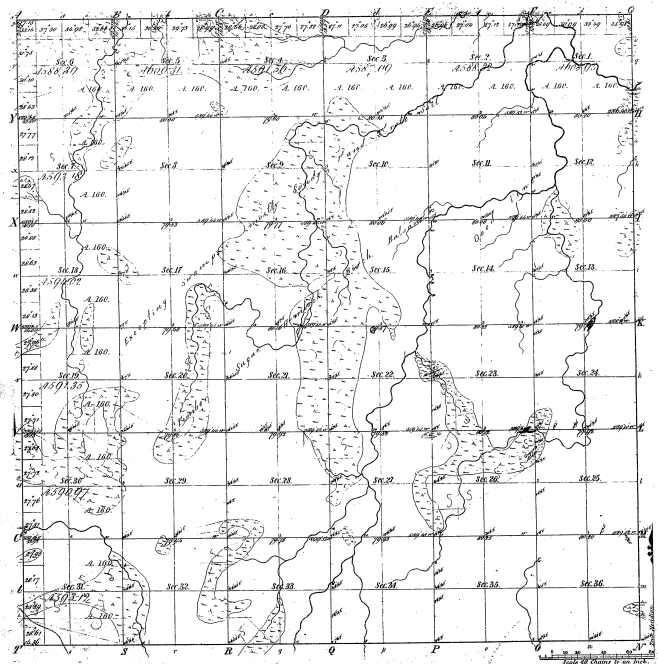

Total number of Acres 22527.96

Surveys Designated	By Whom Surveyed	Date of Contract	Amount of Surveys	When Surveyed	When Plat and Notes in the Surveyor Gen'l's Office?
Township Lines	W. H. Sullivan Dep. Sur.	Aug. 27 1847	4	3rd Quar. 1847	
Subdivisions	A. Morgenweather	Nov. 12 1851	84. 19. 76	3rd Quar. 1852	

The above Map of Township No. 47 North of Range No. 44 West of the Principal Meridian Michigan is strictly conformable to the field notes of the surveys thereof on file in this Office which have been examined and approved.

Surveyor General's Office
Detroit April 28. 1852

Charles Noble
Surv. Genl.

Meanders of					
Pole Courses	Chs. Lks.	Pole Courses	Chs. Lks.	Pole Courses	Chs. Lks.

43-18

8-43