Township No. 50 N. Range No. 35 W. Mer. Mich.

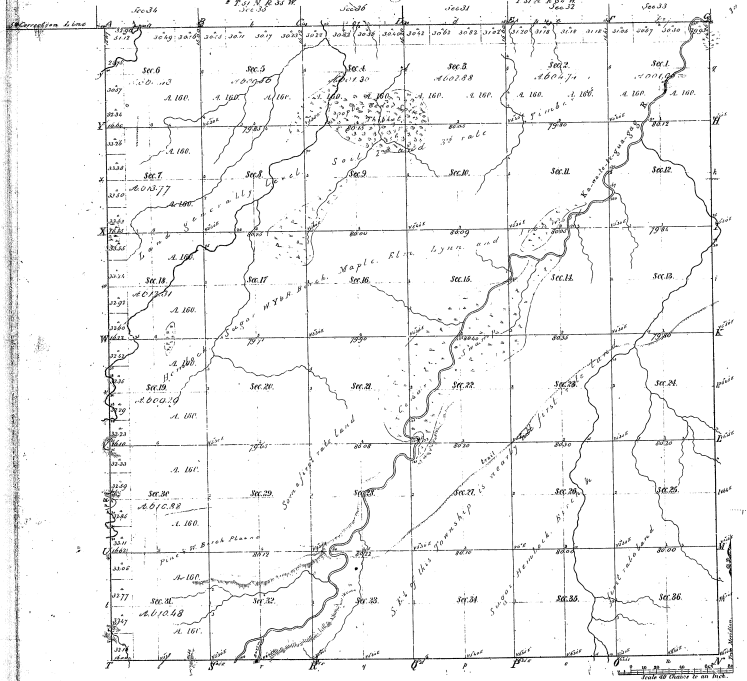

Meanders of

Point	Courses	Dist.	Point	Courses	Dist.	Point	Courses	Dist.

Total number of Acres 22031.65

Surveys Designated	By Whom Surveyed	Date of Contract	Amount of Surveys	When Surveyed	When Plat and Notes in the Surveyor Gen'l's office
Township lines	M. de Pierre	Oct. 7th 1846	M. 05 44	2nd Qr. 1866	
Subdivisions	A. M. Wessing	Bond Jan 29. 1863	Sq. Lk. 86	3rd Qr. 1868	

The above Map of Township No. 50 N. R. of Range No. 35 W. of the Principal Meridian Michigan is strictly conformable to the field notes of the survey thereof on file in this Office, which have been examined and approved.

Surveyor Generals Office.
Detroit, Nov. 27. 1868

Lucius Lyon, Surv. Gen.l