Township No. 13 N. Range No. 11 E., Mer. Mich.

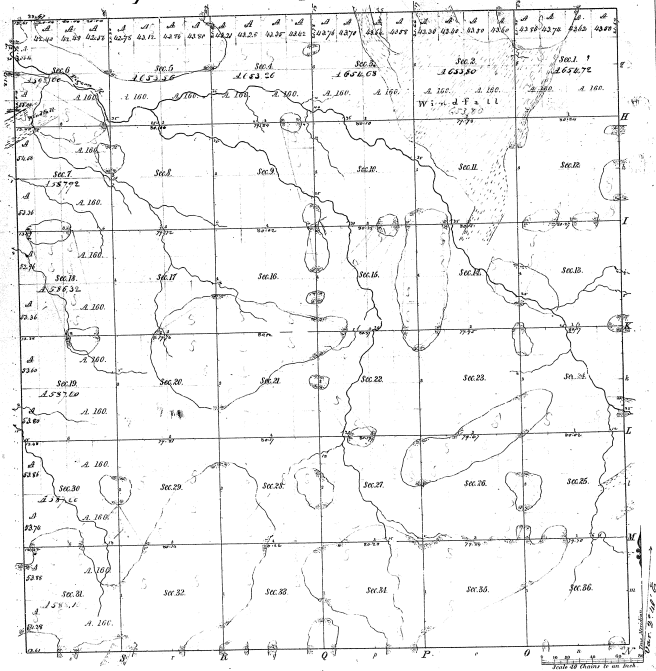

Meanders of

Yeas	Courses	Ch. Lks	Yeas	Courses	Ch. Lks	Yeas	Courses	Ch. Lks

Total number of Acres 23,046.68

Surveys Designated	By Whom Surveyed	Date of Contract	Amount of Surveys	When Surveyed	When plats and abst. in the Gen'l Land Office were received
Township lines	Henry Tucker	25th Dec. 1832	21 Ch. 50 Lks.	1st to 1833	3rd of 1835
Subdivisions	Same	15th May 1834	17 Ch. 88 Lks.	1st to 1835	2nd of 1836

The above Map of Township No. 13 N. of Range No. 11 E. of the Principal Meridian Michigan is strictly conformable to the field notes of the survey thereof on file in this Office, which have been examined and approved.

Surveyor General's Office
Cincinnati.

Surv. Gen.l