Township No 15 N, Range No 15 E, Mer Mich.

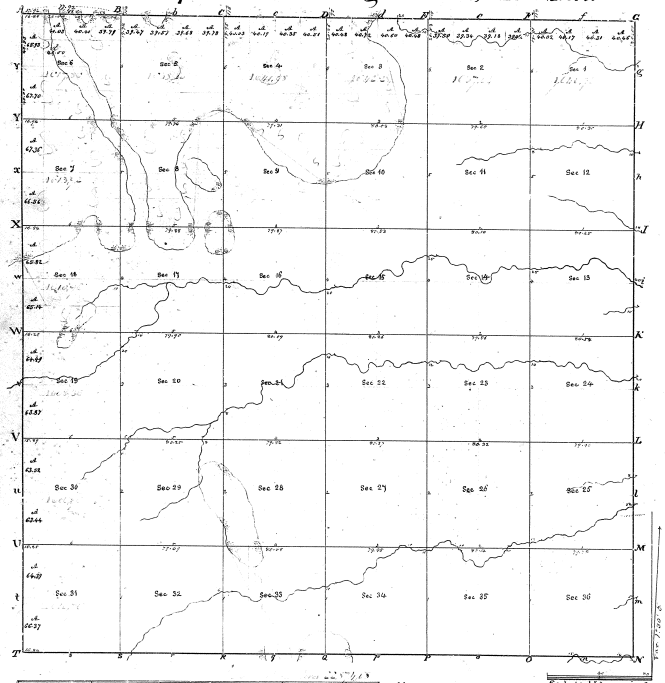

Surveys Designated	By whom Surveyed	Date of Contract	Amt. of Surveys	Time Surveyed	Time of Surveys in the Contract
Subdivision	Schul Ewes	11th Aug. 1834	5 9. 61. 11	6th Oct 1834	1st Oct 1835
Town Lines	Hiram Fisher	20th Oct. 1833	23. 75. 67	6th Aug 1834	

The above Map of Township No 15 N, Range No 15 E, Mer. (Mer. Ter.) is strictly Conformable to the field Notes of the Survey thereof on file in this Office, which have been examined & approved.

Surveyor General's Office
Cincinnati, Mar 30th 1835.

M. T. Williams
Sur. Genl.

25-17

144

25-17