



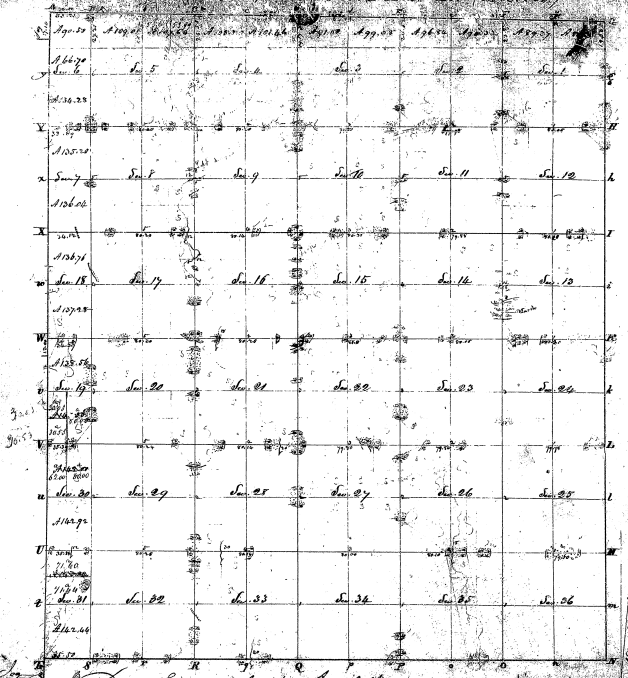


29-40
29-4


