Resurvey

Township No. 21 N. Range No. 7 E. Mer.

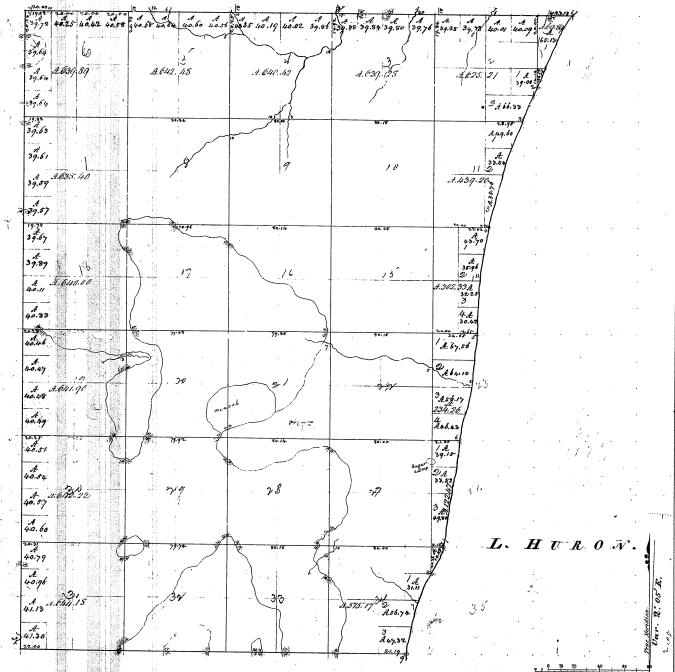

Meanders of

Pass	Courses	Dist. Lks	Pass	Courses	Dist. Lks	Pass	Courses	Dist. Lks

22-37

Total number of Acres 71,107.39

Surveys Dependent.	By Whom Surveyed.	Date of Contract.	Amount of Surveys at Ch'.	Amount of Surveys at Lks.	When Surveyed.	When Charged to the Surv'r Gen'l acc'.
Township Lines.	Lewis Cleaveland	July 10. 1837.	14.	48.	52.	1. of. 1838.	1. of. 1839.
Subdivisions.	Mullett, Wm.	May 27. 1842.	52.	34.	45.	3. of. 1842.	1. of. 1842.

The above Plat of Township No. 21 N. of Range No. 7 E. of the Principal Meridian, Michigan, is strictly conformable to the field notes of the survey thereof on file in this Office, which have been examined and approved.

Surveyor Generals Office, Cincinnati, Nov. 25. 1843.

William Johnston Surv. Gen.