Resurvey

Township No. 24 N. Range No. 9 E. Mer.

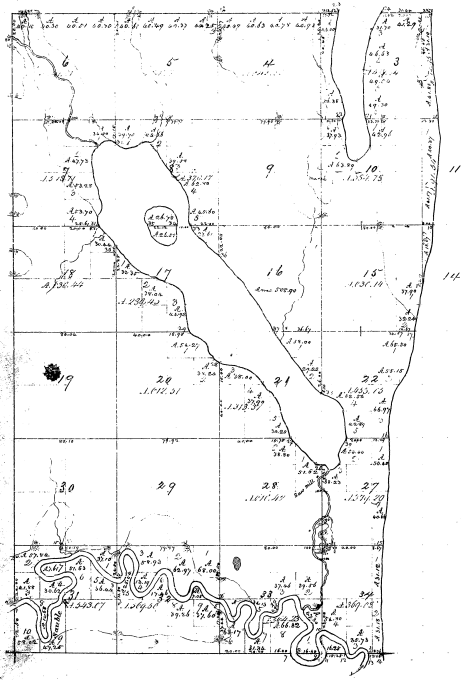

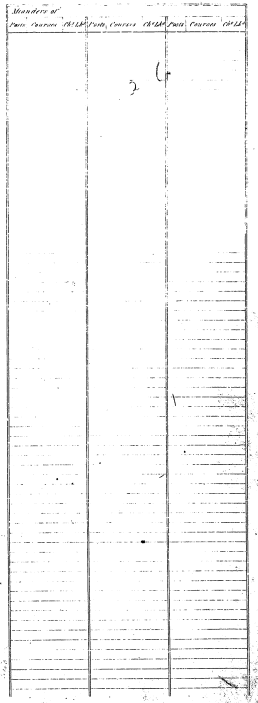

32-6

Total number of Acres 14,642.64

Surveys Designated.	By Whom Surveyed.	Date of Contract.	Date of Survey.	When Surveyed.	When Charged in the Gen'l Land Office.	Remarks.
Township	A. Dexter	Aug. 1st 1837	1838	1839	1842	
Subdivisions.	W. H. Mc Kinstry	May 27th 1842	1842	1843	1843	

The above Map of Township No. 24 N. of Ranges No. 9 East of the Principal Meridian, Michigan, is strictly conformable to the field notes of the survey thereof on file in this Office, which have been examined and approved.

William Johnston
Surveyor General's Office.
Chief Clerk
Commenced Nov. 25. 1843