Township No. 46 N. Range No. 36 W. Mer. Mich.

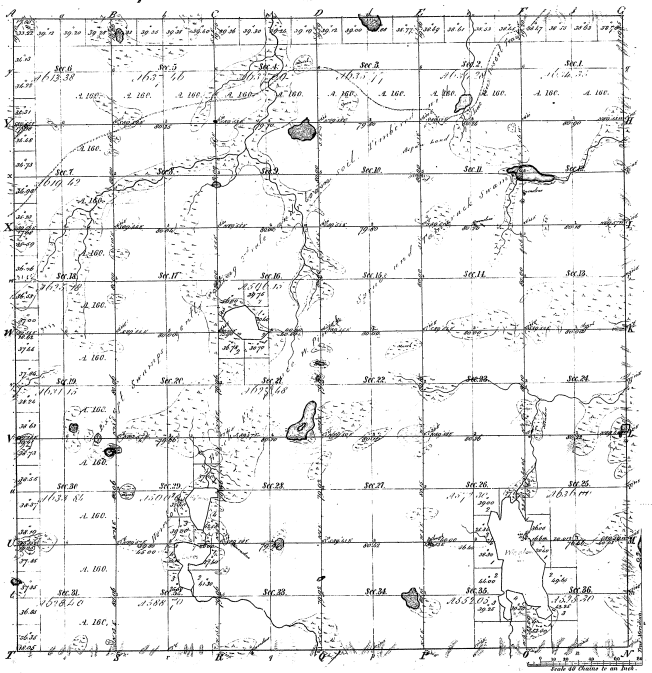

Meanders of								
Posts	Courses	Ch. Lks.	Posts	Courses	Ch. Lks.	Posts	Courses	Ch. Lks.
44-17								

Meas. 7 Posts 6 Chains 65 lks.

Total number of Acres 22499.25

Surveys Designated	By Whom Surveyed	Date of Contract	Amount of Surveys	When Surveyed	When & for what sh.ᵉ in the Surv. Gen.ˡ ᵒᶠᶠ.ᶜᵉ
Township lines	John Ruest	Sept. 7 1847	34. 47/100 Chs. 47/100 Lks.	3ʳᵈ Quar. 1846	
Subdivisions	Harvey Mellen	April 11 1851	66. 00 Chs. 85 Lks.	2ⁿᵈ Quar. 1851	

The above Map of Township No. 46 North of Range No. 36 West of the Principal Meridian Michigan is strictly conformable to the field notes of the survey thereof on file in this Office which have been examined and approved.

Surveyor General's Office,
Detroit Jan. 24. 1852

Charles Noble
Surv.ʳ Genˡ.