12-22

Re-survey of
Township No. 15 N. Range No. 6 W. Mer. Mich.

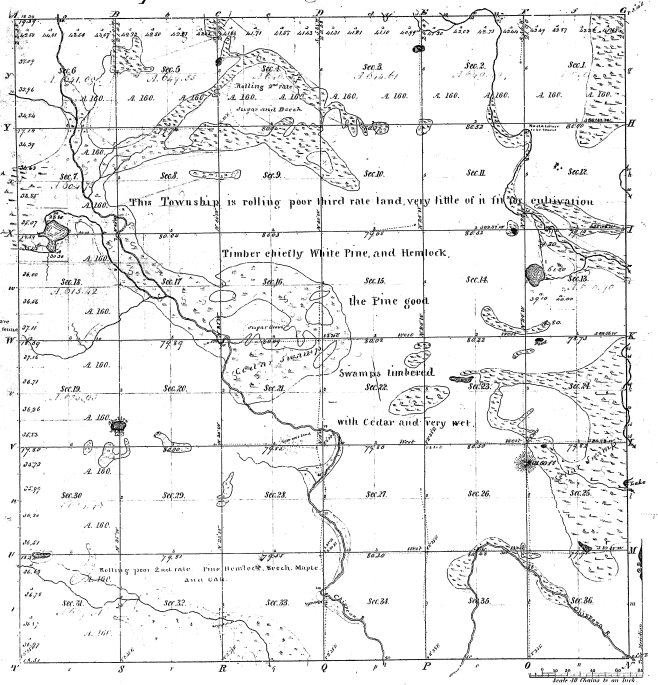

Note
The dotted lines in blue are all the lines that could be found in the Gov. Survey.

Meanders of								
Posts	Courses	Ch.s Lk.s	Posts	Courses	Ch.s Lk.s	Posts	Courses	Ch.s Lk.s

12-22

Total number of Acres.

Surveys Designated	By Whom Surveyed	Date of Contract	Amount of Surveys	When Surveyed	When p.d for and ch.d in the Surv. Gen.l Acc.t
Township lines	John Hereson	Sept 12th 1847	M. Ch.s Lk.s 24 00 00	2 yr 1847	
Subdivisions	Geo. W. Seeley	Sept 14 1847	50 00 00	1 yr 1848	
Resurveyed	Orson Lyon	April 14 1847	61 . 45 . 97	2 yr 1847	

The above Map of Township No. 15 North of Range No. 6 West of the Principal Meridian Michigan is strictly conformable to the field notes of the survey thereof on file in this Office, which have been examined and approved.

Surveyor General's Office
Detroit Sept. 4. 1847

Lucius Lyon
Sur. Gen.l