



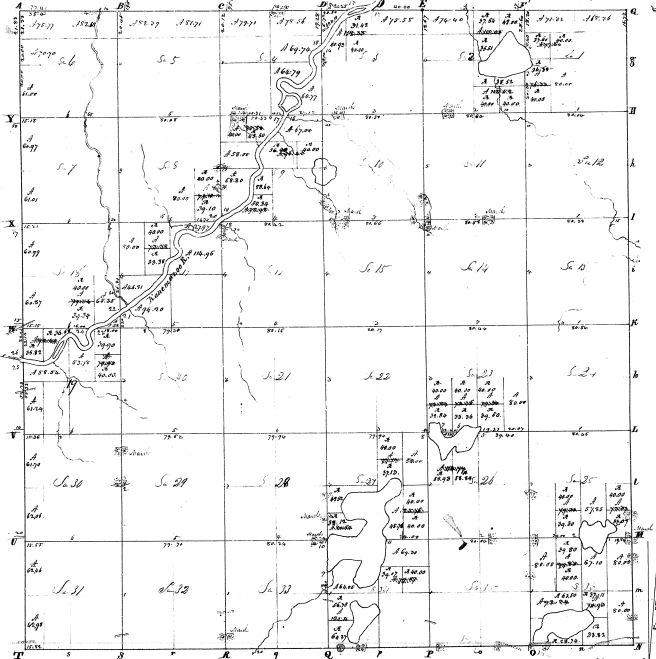

Contd.

Surveyed in November 1834 by John Mallett S.S.

1/4 in. = 60 feet = 1 mile.


3-11