Township N. IV South, Range N. XI West Mer. (Mic. Ter.)

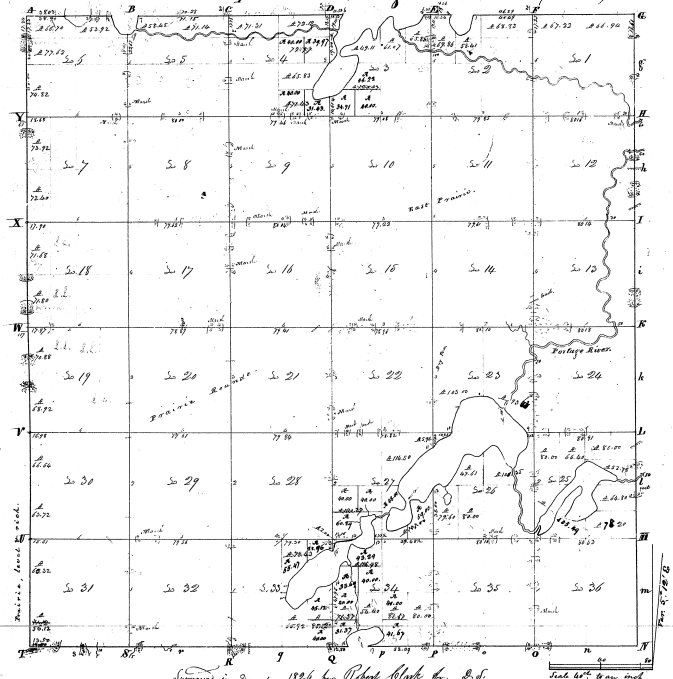

Surveyed in December 1826 by Robert Clark Jr. D.S.

Contents

Section	Acres	Hds.	Section	Acres	Hds.
Mr N E 1	66	94	Er 19	320	
Sr	80		Er N W	80	
Mr N W	67	22	Mr	70	88
Sr	80		Er S W	80	
Sr	320		Mr	68	92
Mr N E 2	68	83	Sr 20	640	
Sr	80		27	640	
Er N W	58	61	22	640	
Mr	69	86	Mr 23	320	
Sr	320		S E Sp	93	63
Er N E 3	65	83	S W Sp	103	
Mr	61	07	Sr 24	640	
E Sp N W	49	11	Mr N E 25	80	
W Sp	19	10	Sr	52	78
S E	160		Er N W	66	40
S W Sp	120	93	Mr	80	
Mr N E 4	72	12	Mr S E	64	80
Sr	79	97	Sr	78	20
Mr N W	71	21	S W Sp	105	49
Sr	80		N E Sp 26	101	35
Mr S E	65	83	S E Sp N W	47	61
Sr	71	43	N W Sp	5	96
S W	160		S E	160	
Mr N E 5	71	14	Er S W	80	
Sr	80		Mr	79	60
Mr N W	58	45	N E Sp 27	114	50
Sr	80		N W	160	
Sr	320		S E Sp	107	
Mr N E 6	53	92	S W Sp	160	29
Sr	80		Sr 28	640	
Mr N W	66	70	29	640	
Sr	77	62	Er 30	320	
S E	160		Er N W	80	
Er S W	80		Mr	66	64
Mr	74	82	Er S W	80	
Er 7	320		Mr	63	72
Er N W	80		Er 31	320	
Mr	73	92	Er N W	80	
Er S W	80		Mr	60	32
Mr	72	40	Er S W	80	
Sr 8	640		Mr	58	12
9	640		Sr 32	640	
10	640		N E Sp 33	78	43
11	640		E Sp S E	85	12
12	640		W Sp	65	92
13	640		Mr	320	
14	640		N E 34	160	
15	640		S E Sp N W	116	98
16	640		N W Sp	2	00
17	640		Er S E	80	
Er 18	320		Mr	81	67
Er N W	80		Er S W	54	40
Mr	71	68	Mr	71	37
Er S W	80		Sr 35	640	
Mr	71	80	36	640	
	11140	31		10789	10
				11140	31
				21,879	41 Total