Township N.V North, Range N.IX West Mer. (Mic. Ter.)

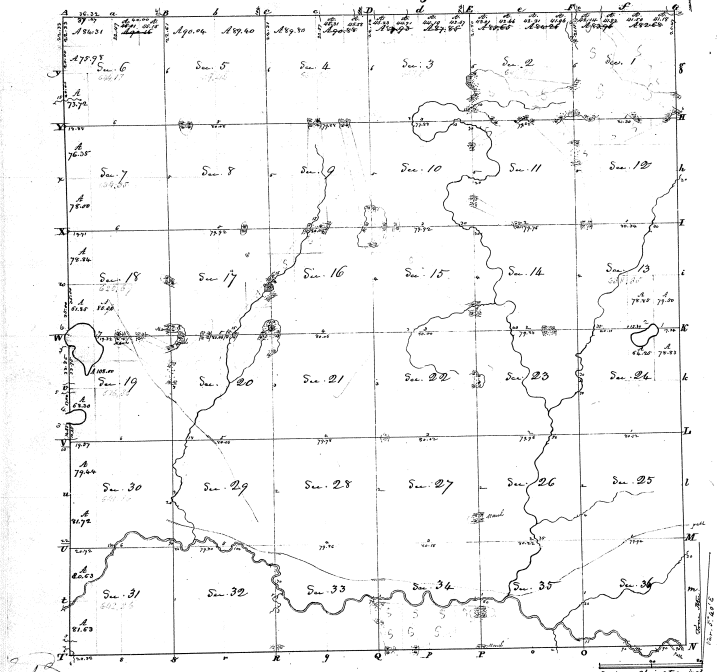

Surveyed in November 1830, by John Mullett, D. S.

Sections			Contents Acres	Cts
N.E.	N.W.	1	72	64
S.E.	"	"	80	
N.E.	N.W.	"	83	96
S.E.	"	"	80	
"	S½	"	320	
N.E.	N.E.	2	84	28
S.E.	"	"	80	
N.E.	N.W.	"	83	65
S.E.	"	"	80	
"	S½	"	320	
N.E.	N.E.	3	87	48
S.E.	"	"	80	
N.E.	N.W.	"	79	92
S.E.	"	"	80	
"	S½	"	320	
N.E.	N.E.	4	90	88
S.E.	"	"	80	
N.E.	N.W.	"	79	80
S.E.	"	"	80	
"	S½	"	320	
N.E.	N.E.	5	87	40
S.E.	"	"	80	
N.E.	N.W.	"	78	06
S.E.	"	"	80	
"	S½	"	320	
N.E.	N.E.	6	90	00
S.E.	"	"	80	
N.E.	"	"	84	31
S.E.	"	"	73	98
"	S½	"	160	
E½	S.W.	"	80	
W½	"	"	73	72
"	E½	7	320	
E½	N.W.	"	80	
W½	"	"	74	35
E½	S.W.	"	80	
W½	"	"	78	00
	Sec.	8	640	
		9	640	
		10	640	
		11	640	
		12	640	
	N½	13	320	
E½	S.E.	"	79	50
W½	"	"	78	85
	S.W.	"	160	
	Sec.	14	640	
		15	640	
		16	640	
		17	640	
	E½	18	320	
E½	N.W.	"	80	
W½	"	"	77	92
E½	S.W.	"	80	
W½	"	"	61	35
			11672	03

Sections			Contents Acres	Cts
E½	N.E.	19	324	
N.W.	"	"	159	00
E½	S.W.	"	80	
W½	"	"	69	30
	Sec.	20	640	
		21	640	
		22	640	
		23	640	
E½	N.E.	24	78	83
W½	"	"	66	25
	N.W.	"	160	
	S½	"	320	
	Sec.	25	640	
		26	640	
		27	640	
		28	640	
		29	640	
E½		30	320	
E½	N.W.	"	80	
W½	"	"	79	44
E½	S.W.	"	80	
W½	"	"	57	72
E½		31	320	
E½	N.W.	"	80	
W½	"	"	80	63
E½	S.W.	"	81	68
W½	"	"	80	
	Sec.	32	640	
		33	640	
		34	640	
		35	640	
		36	640	
			11663	80
			11673	03
		Total	23336	83

1-121