Township No. 18 North, Range No. 11 West Mer. Mic.

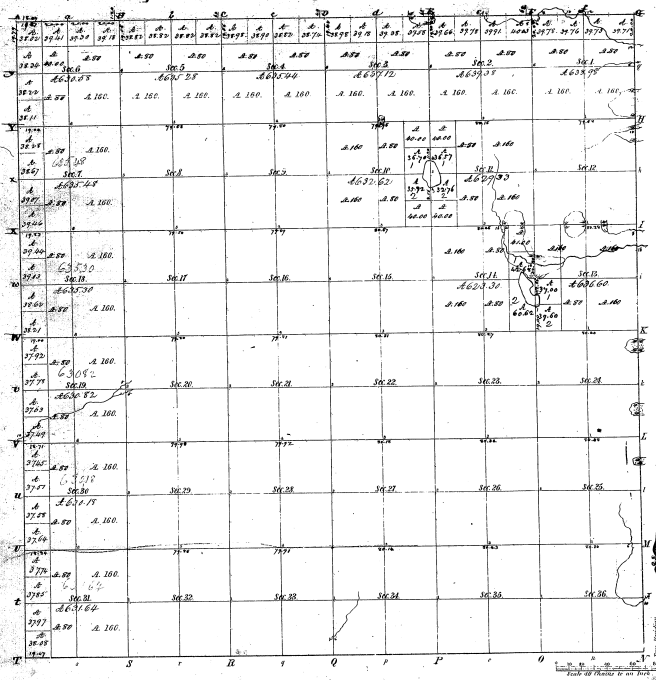

Meanders of Lakes							
Prom.	Courses	Dist.	Prom.	Courses	Dist.	Prom.	Courses	Dist.
Lake on Sec. 13 & 14.							
1	Beach	8.00					
	N 39 W	6.00					
2	N 78 W	4.10					
	N 66 W	4.00					
	N 20 W	4.00					
	N 70 W	4.00					
	N 40 W	1.00					
	N 52 W	13.00					
	N 19 W	8.00					
	N 32 E	15.00					
1	N 72 E	7.00					
Lake on Sec. 10 & 11.							
3	N 73 E	8.00					
	N 24 W	16.50					
4	N 70 E	6.50					
	N 12 W	13.00					
	N 14 E	6.50					
3	N 36 E	4.25					

Total number of Acres 22,942.06

Surveys Designated	By Whom Surveyed	Date of Contract	Amount of Surveys	When Surveyed	When the Lines and Sub-divisions of the Sur. Gen.'l were Established
Township Lines	Joel Rodgers	Jan. 12, 1837	M. CC. Ch. 70 - 76	2nd Qr. 1838	3rd Qr. 1839
Subdivisions	Same	Jan. 30, 1838	61 - 63 - 92	2nd Qr. 1838	4th Qr. 1839

The above Rep.t of Township No. 18 N. (of Ranges No.) 11 W. of the Principal Meridian, Michigan, is hereby approved, to be the official plat of the survey thereof, as the same has been returned and filed in this Office.

Surveyor General's Office
Cincinnati, Oct. 8, 1839

Surveyor Gen.l