


Township No. 30 N Range No. 15 W Mer. Mich.

Part of S. Marquette Island

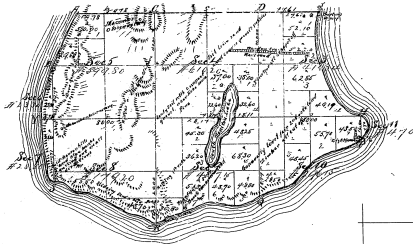

A copy of this Diagram furnished  
to the official Register of Deeds at Mar-  
quette Mich.  
Surveyor General's Office  
April 24 1850

Lake Michigan.

Total Number of Acres 2655.64

Survey Disposition	By Whom Surveyed	Date of Concomit.	When first paid for	When paid for and cleared
Township Lines	<u>O. Riederer</u>	<u>April 14 1847</u>	<u>27. 37. 51. 1/2</u>	<u>1847</u>
Subdivisions	<u>O. Riederer</u>	<u>April 24 1847</u>	<u>16. 27. 41. 5 1/2</u>	<u>1847</u>

The above Map of Township No. 30 North of Range No. 15 West of the Principal Meridian - Michigan, is strictly conformable to the field notes of the survey thereof on file in this office, which have been examined and approved.

Surveyor General's Office,  
Marquette, Mich. 14 1850

Levius Logan  
Surveyor General

2d ed. 6  
Measure 5-22, 74

17-29  
1850

