Township. N.o 45. N. Range N.o 10 W. Mer. Mich.

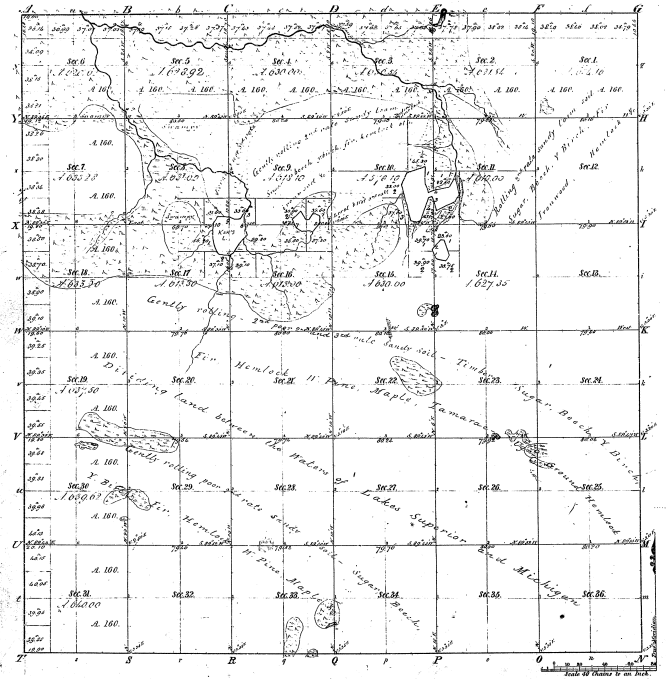

Total number of Acres 22766.73

Surveys Designated	By Whom Surveyed	Date of Contract	Amount of Surveys			Whom Surveyed	When Rec.d and Ent.d in the Surv.r Gen.l's off.e
Township lines	Wm. T. Burt	April 1st 1841	M.	Ch.	Lks.	53rd parallel 1841	
Subdivisions	William Ives	June 7th 1849	63	40	55	53rd " " 1849	

The above Map of Township N.o 45 North of Range N.o 10 West of the Principal Meridian Michigan is strictly conformable to the field notes of the same Survey, and to the Plat thereof, which have been examined and approved.

Surveyor Generals Office
Detroit February 13 1850

Chas. Noble Surv.r Gen.l

Meanders of

30 27

Total Amount of Acres of Swamp Land

35-27