35-24

Township No. 46 N. Range No. 8 W. Mer. Mich.

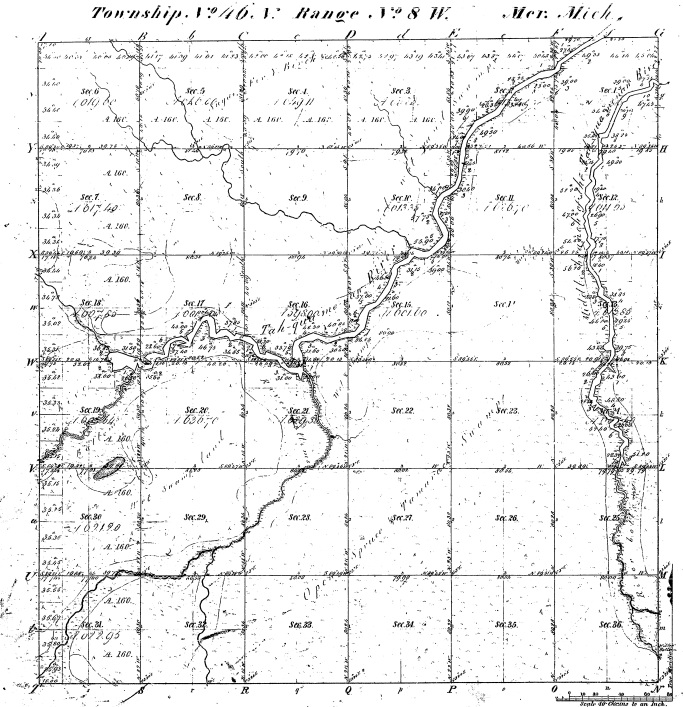

Meanders of							
Posts	Courses	Ch. Lk.	Posts	Courses	Ch. Lk.	Posts	Courses	Ch. Lk.
35-24								

Total number of Acres 22,624.80

Surveys Designated	By Whom Surveyed	Date of Contract	Amount of Surveys	Whose Surveyed	When p.d for and ch.d on the Inv.r Gen.l Gen.l
Township lines	William A. Burt	January 15. 1840	11 Oct. 60 / 12 60 60	2nd Quar. 1840	
Subdivisions	Wells Burt	April 26. 1850	85 106 68	2nd & 3rd Quar. 1850	

The above Map of Township No. 46 North of Range No. 8 West of the Principal Meridian Michigan is strictly conformable to the field notes of the survey thereof on file in this Office, which have been examined and approved.

Surveyor General's Office
Detroit June 13. 1851

Charles Noble
Spr. Genl.