Township No. 46 N. Range No. 11 West Mer. Mich

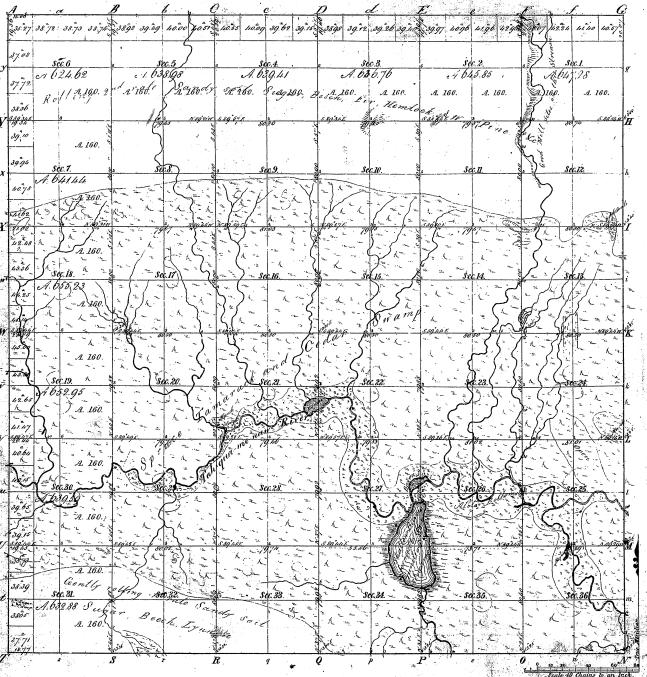

Meanders of								
Posts	Courses	Ch. Lk.	Posts	Courses	Ch. Lk.	Posts	Courses	Ch. Lk.
35 = 21								

35-21

Total number of Acres. 23,054.99

Surveys Designated	By Whom Surveyed	Date of Contract	Amount of Surveys	When Surveyed	When p.d for and 3d. in the Sur. Gen.ls acc.d
Township lines	Wm. A. Burch	April 1 1851	M. Ch. Lks. 71 72 74	3rd Quar. 1851	
Subdivisions	Francis Colman	April 9 1851	59 57 45	3rd Quar. 1851	

The above Map of Township No. 46 North of Range No. 11 West of the Principal Meridian Michigan is strictly conformable to the field notes of the survey thereof on file in this Office, which have been examined and approved.

Surveyor General's Office
Detroit June 30 1852

Charles Noble
Sur. Gen.l

