Correctional Survey

Township N° 49 N Range N° 10 W. Mer. Mich.

LAKE SUPERIOR

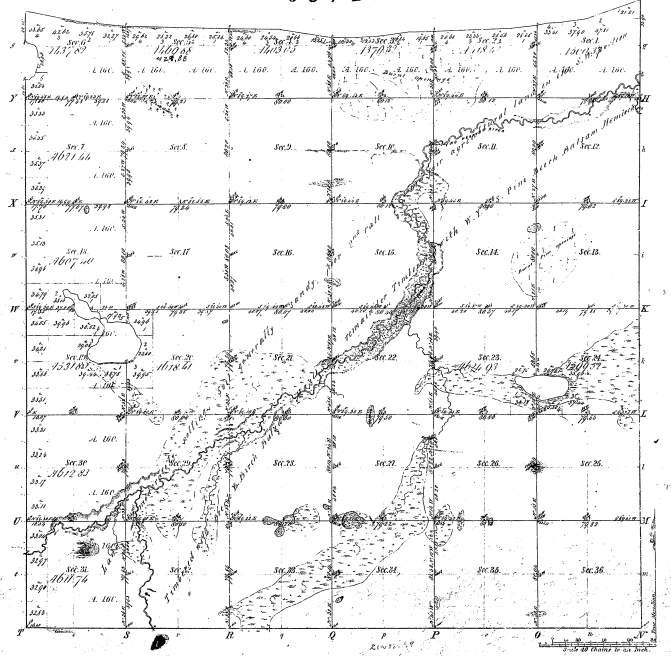
Sec. 1
Sec. 2
Sec. 3
Sec. 4
Sec. 5
Sec. 6
Sec. 7
Sec. 8
Sec. 9
Sec. 10
Sec. 11
Sec. 12
Sec. 13
Sec. 14
Sec. 15
Sec. 16
Sec. 17
Sec. 18
Sec. 19
Sec. 20
Sec. 21
Sec. 22
Sec. 23
Sec. 24
Sec. 25
Sec. 26
Sec. 27
Sec. 28
Sec. 29
Sec. 30
Sec. 31
Sec. 32
Sec. 33
Sec. 34
Sec. 35
Sec. 36
