Township No. 41 N. Range No. 11 W. Mer. Mich.

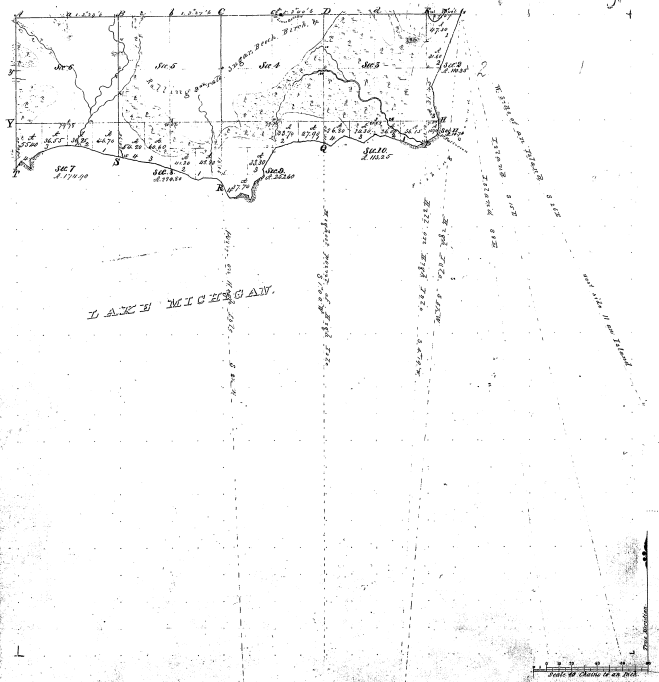

Meanders of								
Posts	Courses	Ch. Lk.	Posts	Courses	Ch. Lk.	Posts	Courses	Ch. Lk.

35-40

Total number of Acres 3506.60

Survey Designated.	By Whom Surveyed.	Date of Contract.	Amount of Survey. M. Ch. Lk.	When Surveyed.	When Charged in the Surv. Genl's acct.
Township lines, Subdivisions	John Bush	Feby 26 1845	15 41 10	3d qr. 1845	

The above Map of Township No. 41 North of Range No. 11 West of the Principal Meridian Michigan is strictly conformable to the field notes of the survey thereof on file in this Office, which have been examined and approved.

Surveyor General's Office,
Detroit Feb. 24 1846.

Lucius Lyon, Surv. Genl.