Township No. 45 N. Range No. 6 W. Mer.

3H 36

34-36

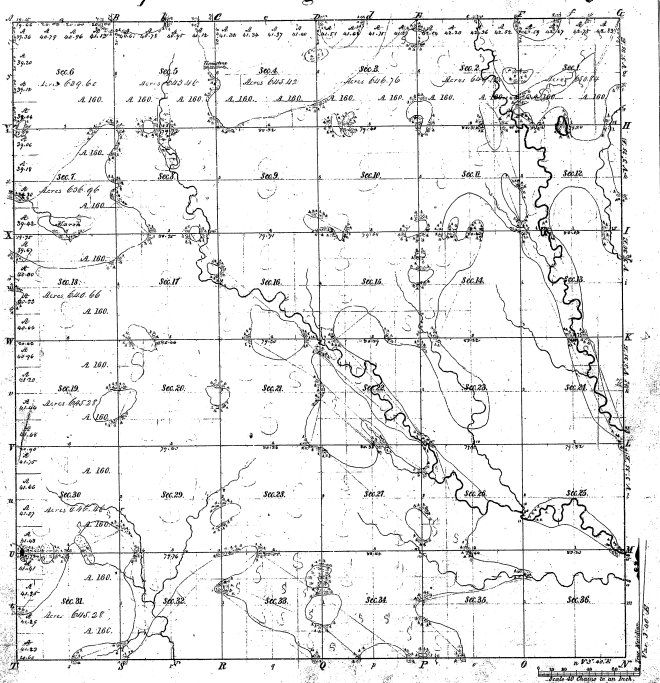

Meanders of							
Point	Courses	Ch. Lk.	Point	Courses	Ch. Lk.	Point	Courses	Ch. Lk.

1605
1.82
3145
3.97

Total number of Acres 23,559.34

Surveys Designated	By Whom Surveyed	Date of Contract	Amount of Surveys	When Surveyed	When Plat of Lot and of the Sub Divs. rec'd.
Township Lines	Wm. H. Chase	Aug. 25th 1874	M. Ch. Lks.	3rd Qr. 1874	
Subdivisions	Henry Chase and F. Pierce	Sept. 1st 1875	86. 62. 33	3rd Qr. 1875	


Surveyor General's Office
Detroit, Sept. 9th 1875

Surveyor General

Scale 40 Chains to an Inch.