Township. N°43. N. Range N°8 West Mer. Michigan.

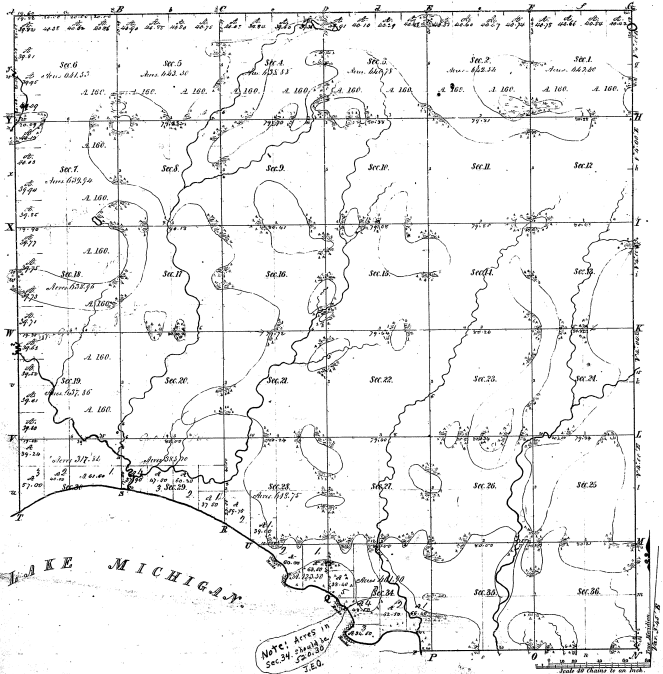

Meanders of					
Prots Courses	Dist.s	Prots	Courses	Dist.s	Prots	Courses	Dist.s

35-3 E

Total number of Acres 20,350.38

Surveys Designated.	By Whom Surveyed.	Date of Contract	Amount of Surveys	When Surveyed.	Whether on or off the Base or Mer.
Township lines	Jared Sibley	2d Feb. 1805	42 Miles	2d 1820	
Subdivisions	H. Chamberlain	8th April 1825	89 . 35 . 94	2d 1832	

The above Map of Township N°43 North of Range N°8 West of the Principal Meridian Michigan is strictly conformable to the field notes of the survey thereof on file in this Office, which have been examined and approved.

Surveyor Generals Office, Detroit Sept. 6th 1835

Lucius Lyon, Surv. Genl.