Township No. 43 N. Range No. 9 W. Mer. Mich.

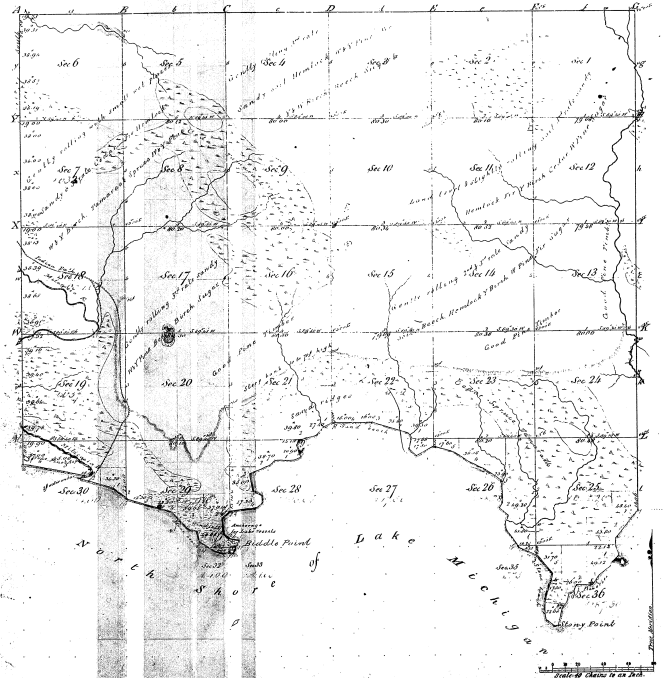

Meanders of								
Posts	Courses	Ch.s Lk.s	Posts	Courses	Ch.s Lk.s	Posts	Courses	Ch.s Lk.s

35-34

Total number of Acres 7246.05

Surveys Designated.	By Whom Surveyed.	Date of Contract.	Amount of Surveys Ch.s Lk.s	When Surveyed.	When surveyed to the Surv.r Gen.l's Ofc.
Township lines.	William Ferry	[illegible]	54	2nd qr. 1840	
Subdivisions.	William Ferry	June 7th 1842	28.03	3rd qr. 1849	

The above Map of Township No. 43 North of Range No. 9 West of the Principal Meridian, Mississippi is strictly conformable to the field notes of the survey thereof on file in this Office, which have been examined and approved.

Surveyor General's Office
Detroit Mich. Aug. 23rd 1849

Lucius Lyon, Surv.r Genl.