Township No. 43 N. Range No. 11 W. Mer. Mich.

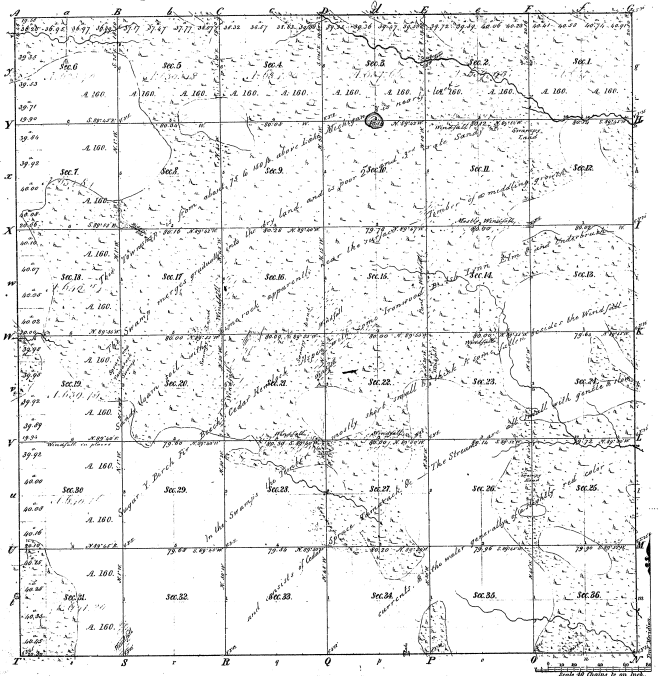

Meanders of							
Posts	Courses	Dist.	Posts	Courses	Dist.	Posts	Courses	Dist.

35-36

Total number of Acres 23012.36

Surveys Designated	By Whom Surveyed	Date of Contract	Amount of Surveys	When Surveyed	When plat for and abst. in the Surr. Gen.'s Office
			M. Chs. Lks.		
Township Lines	Wm. A. Burt	April 18th 1843		4th Quart. 1845	
Subdivisions	William Ives	June 7th 1849	59. 77. 26.	4th Quart. 1849	

The above Map of Township No 43 North of Range No 11 West of the Principal Meridian Michigan is strictly conformable to the field notes of the survey thereof on file in this Office, which have been examined and approved.

Surveyor Generals Office.
Detroit Sept. 30th 1852

Charles Noble Surr. Gen.l