Township No. 43 N. Range No. 12 W. Mer. Mich.

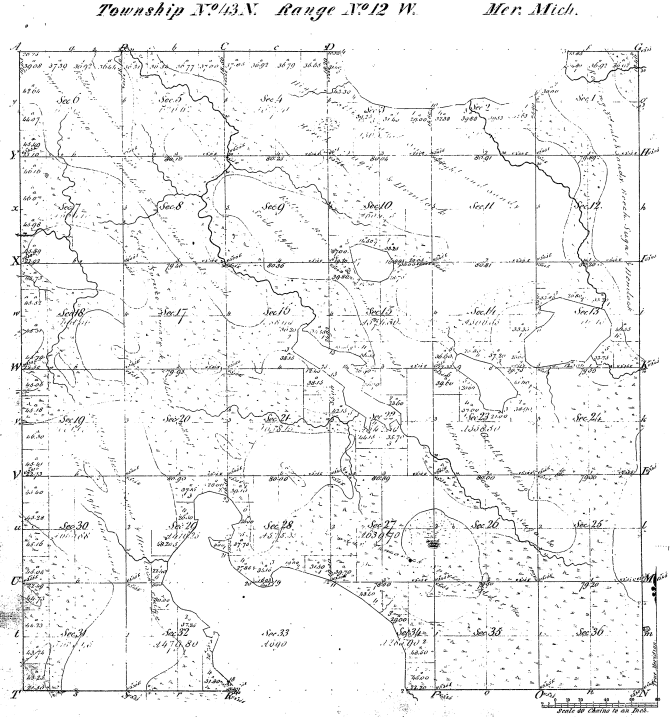

Meanders of								
Posts	Courses	Ch. Lks.	Posts	Courses	Ch. Lks.	Posts	Courses	Ch. Lks.
3	20	24						

36-29

Total number of Acres 20418 61

Surveys Designated.	By Whom Surveyed.	Date of Contract.	Amount of Surveys M. Ch. Lks.	When Surveyed.	When Changed in the Surv. Genl's Acct.
Township Entire.	Wm. A. Burt	April 5th 1844	101 08 09	[illegible]	
Subdivisions.	Geo. H. Bachelor	July 14th 1849	72 38 55	8th Quarter 1849	

The above Map of Township No. 43 North of Range No. 12 West of the Principal Meridian Michigan is strictly conformable to the field notes of the survey thereof on file in this Office which have been examined and approved.

Surveyor General's Office
Detroit April 15th 1858

Charles Noble Surv. Genl.

16