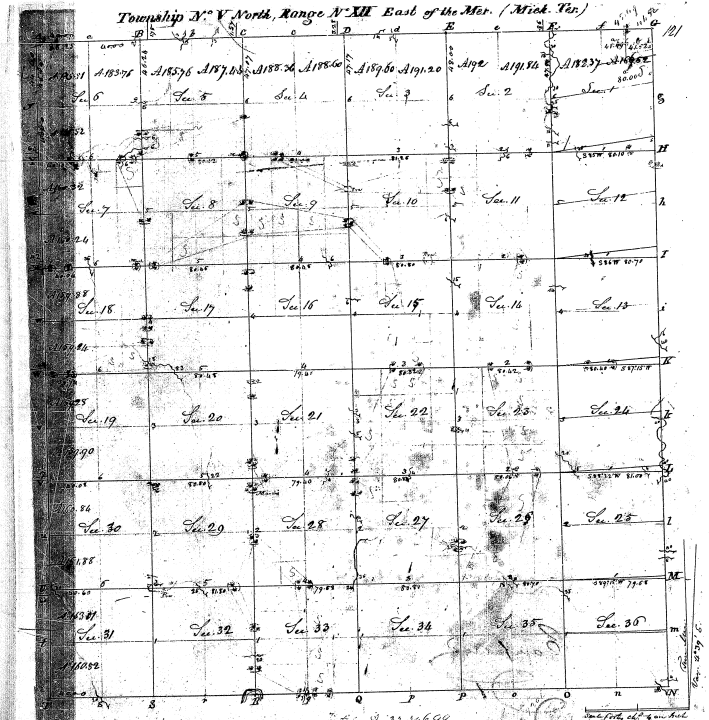

Pursuant to a contract with the said Instructions from Edward Tiffin, Esquire Surveyor General of the United States bearing date the day of I have actually surveyed the land and made Survey of the above described Township and the Boundary and Subdivision lines of the said Township and returned the Plat and Notes of the same to the Surveyor Genl's Office — Certified this 3 day of July 1819

J. Mansfield D.S.

27-21