Township No. 21 North, Range No. 14 West Mer. (Mich.)

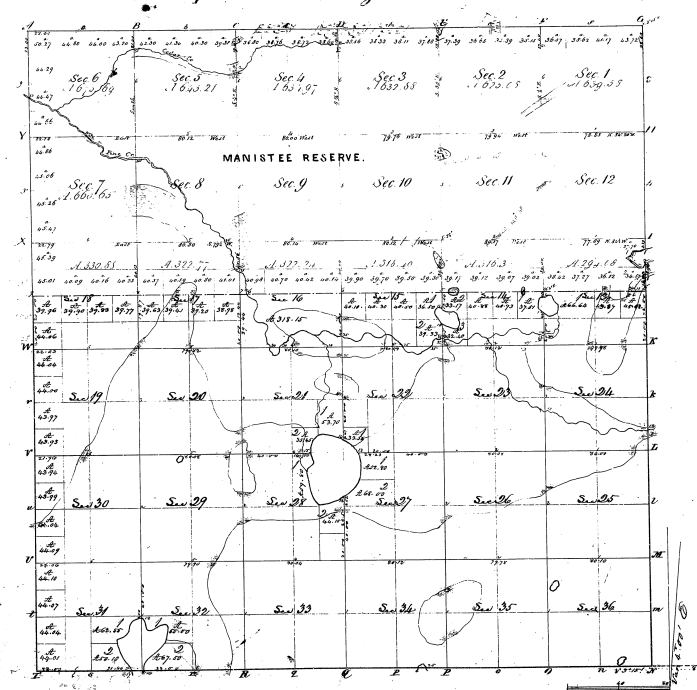

Meanders of Lake No. 1 Known as Big Bear Lake		
Lake in Volume 24, 22, 23, 24		
3	N 23 G	7.24
	S 81 W	6.51
	S 10 G	6.51
	W 1 G	12.51
	N 32 G	6.00
	N 56 G	5.50
12	N 46 G	19.00
	N 76 G	8.50
	N 39 G	13.50
13	S 41 W	26.00
	S 79 W	1.50
	S 47 W	12.50
14	S 18 W	3.00
	S 42 W	7.50
	S 52 W	11.50
	S 58 W	7.00
15	S 41 W	12.50

Part of Lake in Volume 24, 22		
10	South	7.00
	S 32 W	22.50
	S 71 W	12.50
	S 76 W	8.50
	N 61 W	16.50
9	S 23 W	17
	S 70 W	3.00
	S 85 W	11.50
	S 61 W	7.00
	S 49 W	10.50
17	S 29 E	16.50
	S 39 E	11.50

Lake in Volume 24, 22, 13		
11	N 69 W	2.00
	N 61 W	4.50
	S 8 W	4.50
10	S 29 E	2.50
	S 70 E	11.50
	S 76 E	6.50
	S 78 E	7.50
11	S 77 E	12.00

Lake in Section 13, 22, 12		
2	N 52 W	3.50
	N 18 W	7.50
1	N 26 E	2.50
	N 65 W	5.00
	N 76 E	7.50
	S 35 E	8.25
	S 49 E	3.50
	S 82 E	7.50
2	S 79 W	6.50

The above Meander of part of the Manistee Reserve in Township 21 North & Range 14 West of the Principal Meridian Michigan is conformable to the plat which is returned to this office. Which was commenced and completed during the year 1838

Surveyor General's Office
Detroit March 16th 1839

Surveyed Aug. and Sept. 1838

21-14

17-35

Surveys Returned	By Whom Surveyed	Date of Contract	When Surveyed	Date of Survey	Miles in Township	Miles in Sections
Township Lines	John Rinsle	Nov 4th 1836	31st 1837	26. 09. 72	3rd 1838	
Subdivisions Manistee Reserve	Same	Feb 18. 1839	4th 1838	44. 75. 21	3rd 1839	
		Aug 24. 1839	1st 1839	24. 72. 21		

The above Maps of Township No. 21 North, Range No. 14 West of the Principal Meridian Michigan, is strictly Conformable to the field notes of the survey thereof on file in this Office, which have been examined and approved.

Surveyor General's Office
Examined July 31st 1839