Township No. 46 N Range No. 23 W Mer. Mich.

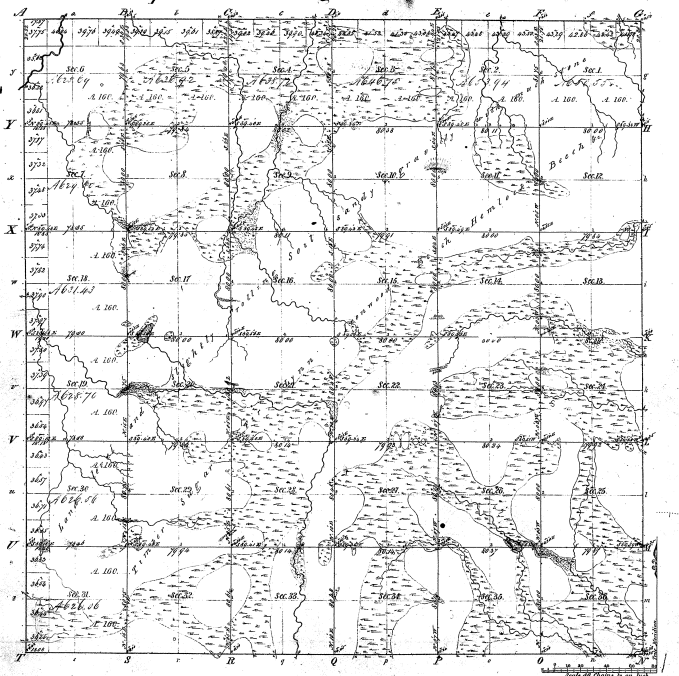

Meanders of								
Posts	Courses	Ch. Lk.	Posts	Courses	Ch. Lk.	Posts	Courses	Ch. Lk.
38	5							

38-5

Total number of Acres: 22.994.92.

Surveys Designated	By Whom Surveyed	Date of Contract	Amount of Surveys	When Surveyed	When pr. fee and ch. in the Surv. Gen. Ofc. sent
Township lines	W. A. Burt	April 1st 1841	M. Ch. Lk. 77 78 76	3d Quar. 1841	
Subdivisions	A. D. Sullivan	Bond Oct. 30 1852	60. 02. 43	3d Quar. 1852	

The above Map of Township No. 46 N of Range No. 23 W of the Principal Meridian of Michigan is strictly conformable to the field notes of the survey thereof on file in this Office which have been examined and approved.

Surveyor General's Office,
Detroit December 1 1853

Leander Chapman
Spr. Genl.