Township No. 50 N Range No. 25 W Mer: Mich

39-40

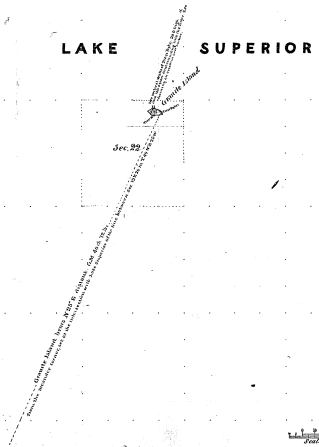

Meanders of								
Poles	Courses	Ch^s Lk^s	Poles	Courses	Ch^s Lk^s	Poles	Courses	Ch^s Lk^s

39-40

Total number of Acres 2 25

Survey Designated.	By Whom Surveyed.	Date of Contract.	Amount of Surveys M. Ch^s Lk^s	When Surveyed.	When Charged in the Surv^r Genl's acct.
Township lines.					
Meanders & Subdivision.	Holland & Sons.	Sept 7 1846.	0 21 50	3rd qr 1846	

The above Map of Township No. 50 North of Range No. 25 West of the Principal Meridian, Michigan is strictly conformable to the field notes of the survey thereof on file in this Office, which have been examined and approved.

Surveyor Generals Office, Detroit Mich. 22 1847

Lucius Lyon, Surv^r Genl