Township No. 51 N. Range No. 26 W. Mer. Mich.

39-17

39-17

LAKE SUPERIOR.

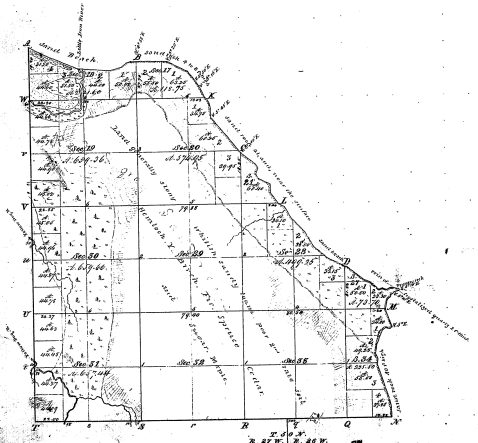

T. 51 N.
R. 27 W. R. 26 W.

Total number of acres 5680.61

Surveys Completed.	By Whom Surveyed.	Date of Contract.	Amount of Surveys Rejected. M.	Ch.	Lks.	When Surveyed.	When Charged in the Surr. Gen'l's Off.
Township Lines.	Alex. C. Edmonds	June 23 1846				Jan 1848	
Subdivisions.	Wells & Chase	July 7th 1846	20	64	65	Dec 1848	

The above Map of Township No. 51 North of Range No. 26 West of the Principal Meridian, Michigan, is strictly conformable to the field notes of the survey thereof, on file in this Office, which have been examined and approved.

Surveyor Generals Office
Detroit March 29 1849

Lucius Lyon, Surv. Genl.

Boundaries of Pairs	Courses	Dist. Lks.	Pairs	Courses	Dist. Lks.	Pairs	Courses	Dist. Lks.