39-16

Township No. 51 N. Range No. 27 W. Mer. Mich.

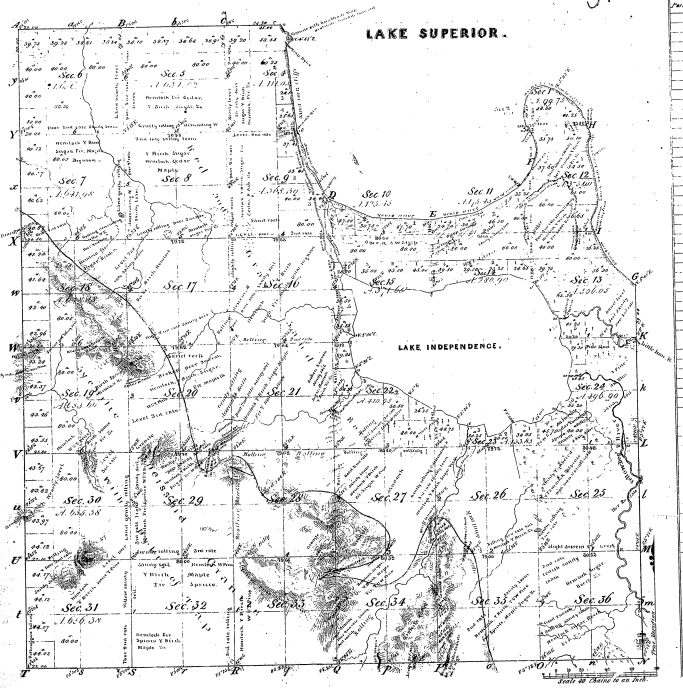

Meanders of:									
Posts	Courses	Ch's Lk's	Posts	Courses	Ch's Lk's	Posts	Courses	Ch's Lk's

Total number of Acres 18,089.58

Surveys Designated.	By Whom Surveyed.	Date of Contract.	Amount of Surveys M. Ch's Lk's	When Surveyed.	When Changed to the Sec'l Gen'l Ass'l
Township lines.	Wm. A. Burt	Decr. 25 1842		1st Qr. 1842	
Subdivisions.	Bullard & Ogden	Sept. 7th 1846	61 69 70	3rd Qr. 1846	

The above Map of Township No. 51 North of Range No. 27 West of the Principal Meridian. Michigan is strictly conformable to the field notes of the survey thereof on file in this Office, which have been examined and approved.

Surveyor General's Office
Detroit March 22 1847

Lucius Lyon Sur. Genl.