



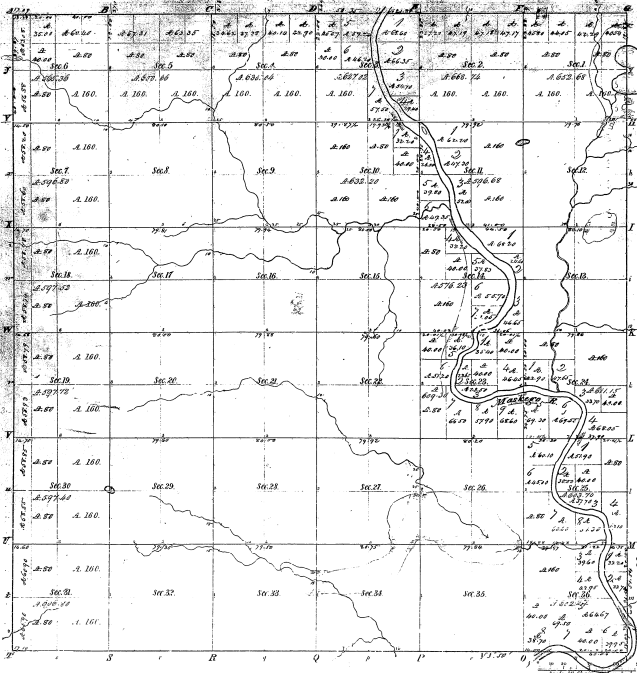

Boundaries of Township






11-22

