Resurvey

Township No. 16. N. Range No. 7. W. Mer: Mich.

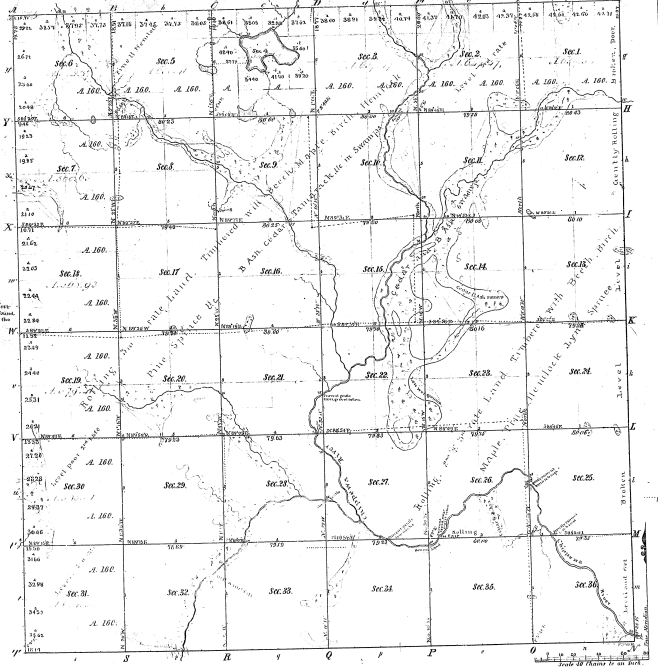

Note
The meanderings in blue, of all the lines of this Survey, which could be found, of the Resurvey, making the Contents.

Meanders of					
Poles	Courses	Acres	Poles	Courses	Acres

12-18

12-18

Total number of Acres

Surveys Designated	By Whom Surveyed	Date of Contract	Amount of Surveys	When Surveyed	When Plats of the Sur. Gen.l were Rec.d	
			A. Qrs Lks.			
Township lines	Solon Kerlinen	[illegible] 22nd 1837	23 00 00	4th Sep. 1837	31st Sep. 1838	
Subdivisions	Orsen Lyon	Office 14th 1837	6146 00	3 rd Sep. 1837		
Resurvey (Old lines)	Solon Kerlinen	Sept 18. 1837	64 17 56	7th Sep. 1838		

The above Map of Township 16 North of Range 7 West of the Principal Meridian Michigan is strictly conformable to the field notes of the survey thereof on file in this Office, which have been examined and approved.

Surveyor Generals Office.
Detroit Oct 18th 1838

Charles Eagan, Surv.r Gen.l