Resurvey

Township N.o 16 N. Range N.o 8 W. Mer. Mich.

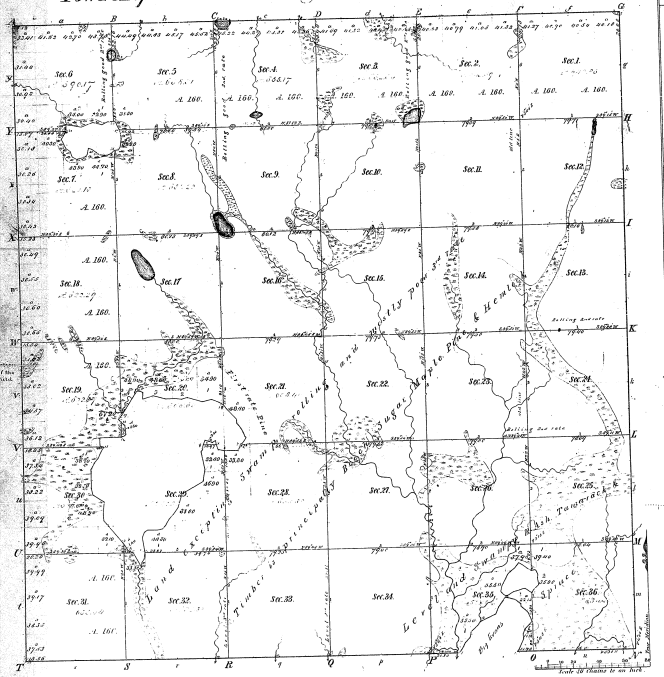

Note. The red lines represent the bounds of sections, now a mark of the original survey as could be found.

Meanders of					
Posts	Courses	Ch. Lks.	Posts	Courses	Ch. Lks.

12-17

Total number of Acres 187.84

Surveys Designated	By Whom Surveyed	Date of Contract	Amount of Surveys	When Surveyed	When Plat and Field Notes Rec.d Gen.l Off.ce
			M. Ch. Lks.		
Township Lines	[illegible]	[illegible] 12 1847	24 72 [illegible]	[illegible] 1847	
Subdivisions	[illegible]	Sept. 18 1847	163 [illegible]	Sept. 1847	
Meanders of	[illegible]	[illegible] 1847	83 03 24	Sept 1847	

The above Map of Township 16 North of Range 8 West of the Principal Meridian is strictly conformable to the field notes of the survey thereof on file in this office, which have been examined and approved.

Surveyor Generals Office
Detroit Feb 1848

Surv.r Gen.l