Township No. 38 N. Range No. 27 W. Mer. Mich.

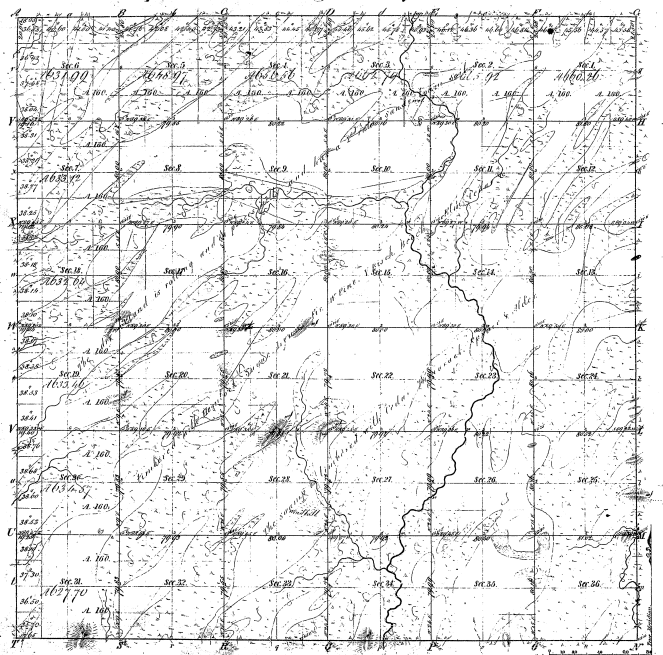

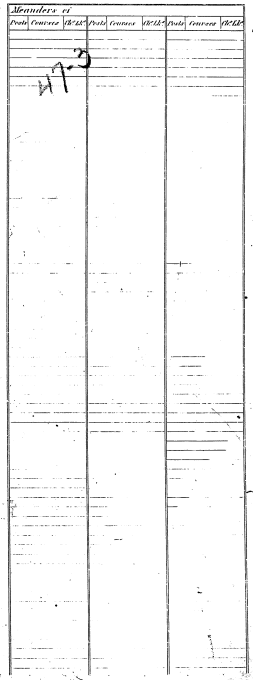

47-3

47-3

Total number of Acres 23087.08

Surveys Designated	By Whom Surveyed	Date of Contract	Amount of Charges	When Surveyed	When the work was returned to the Surr. Gen.'s Office
Township lines	Solon Mallett	June 24 1847	$ 85.12	2nd Quar. 1848	
Subdivisions	Harvey Mellen	Dated Sep 23 1850	79.12	3 years 1852	

The above Map of Township No. 38 North of Range No. 27 West of the Principal Meridian Michigan is strictly conformable to the field notes of the survey thereof on file in this Office which have been examined and approved.

Surveyor Generals Office
Detroit Dec 31 1852

Chas. Mellen
Surv. Gen.