Township No. 38 N. Range No. 28 W. Mer. Mich.

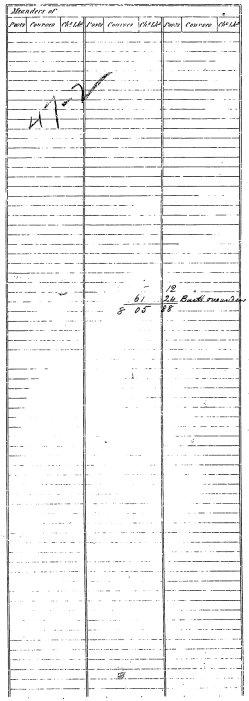

47-8

Surveys Designated.	By Whom Surveyed	Date of Contract.	Amount of Surveys. M.	Ch's	Lks	When Surveyed	When Changed to the Quadrant east
Township lines.	John Mullett	June 28. 1847	11.	33.	60	Nov. 1848.	
Subdivisions.	James H. Mullett	June 27. 1849	62.	33.	46	Nov. 1850	

Total number of Acres 20,276.04

The above Maps of Township 38 North of Range 28 West of the Principal Meridian, Michigan is strictly conformable to the field notes of the survey thereof on file in this Office, which have been examined and approved.

Surveyor Generals Office
Detroit Dec. 3th 1850

Charles Bolles Surv. Genl