Township № 39 N. Range № 26 W. Mer. Mich.

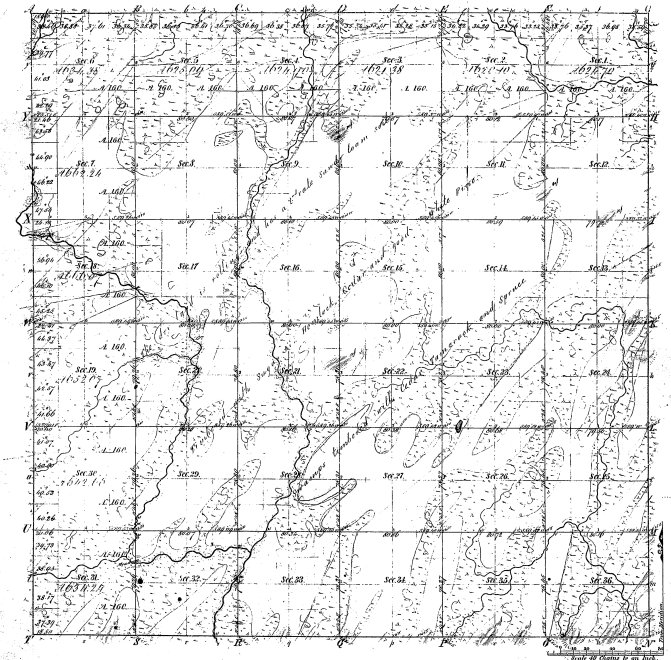

Meanders of

Prairie Course	West	Prairie Courses	West	Prairie	Courses	West

46-27

Total number of Acres 23267.31

Surveys Designated	By Whom Surveyed	Date of Contract	Journal of Surveys Returned	When Surveyed	When Plat of sec and of the Sur. Gen.l was rec'd
Township Lines	John Mallett	June 26. 1838.	Nov. 25. 26.	3rd Quar. 1838	
Subdivisions	Harvey Miller	Deed Sept. 26. 1852	Sep. 27.	3rd Quar. 1852	

The above Map of Township (№) 39 North of the Principal Meridian Mich is hereby conformable to the field notes of the survey thereof on file in this Office, which have been examined and approved.

Surveyor Generals Office
Detroit Dec. 14. 1852

Charles Noble
Surv.r Gen.l