Township No. 39 N. Range No. 27 W. Mer. Mich.

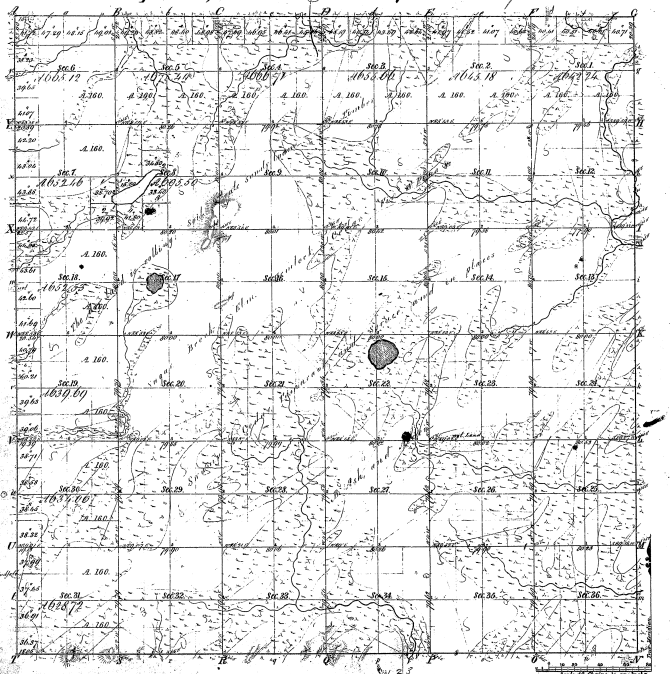

Meanders of

Point	Courses	Dist.	Point	Courses	Dist.	Point	Courses	Dist.

46-28

46-28

Meander Corr. adj. Sec. line
1. 19. 60

Total number of Acres 23763.31

Surveys Designated	By Whom Surveyed	Date of Contract	Amount of Surveys	When Surveyed
Township lines	Jesse Stoddard	June 27. 1834	M. 98 Ch.	2nd Quar. 1852
Subdivisions	Hazen Mellen	December 30. 1852	61. 21 Ch.	2nd Quar. 1852

When 2d cor. and 1/4 cor. Sec. Cor. to cor.

The above Map of Township No. 39 North of Range No. 27 West of the Principal Meridian Michigan is strictly conformable to the field notes of the Survey thereof on file in this Office, which have been examined and approved.

Surveyor Generals Office
Detroit, Dec 17 1852

Charles Noble Surv. Genl