390 2

Township. No 30. N. Range. No 2. E. Mer. Mich.

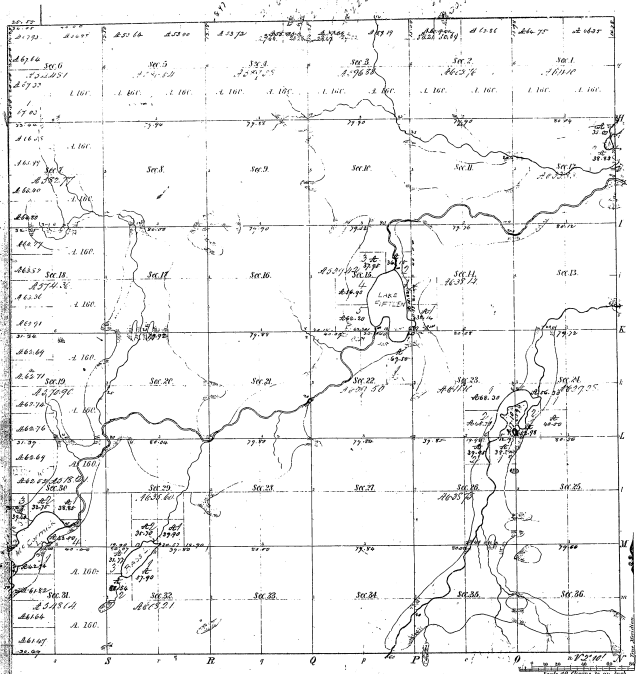

Total number of Acres 23,119.83

Surveys Designated	Northern Surveyed	Date of Contract	Amount of Surveys	When Surveyed	When and on what Ins. Gen.l Mans.
Township.	West		M. Ch. Lks.		

The above Map of Township No. 30 N. of Range No. 2 E. of the Principal Meridian Michigan is strictly conformable to the field notes of the Surveys thereof on file in this Office, which have been examined and approved.

Surveyor Generals Office
Cincinnati Aug. 3. 1840

E. A. Brady Surv. Gen.l

Meanders of Small Lakes.

Lake in Section 12

Lake in Section 12					