Township No. V North, Range No. X East of the Men. (Mich Ter.)

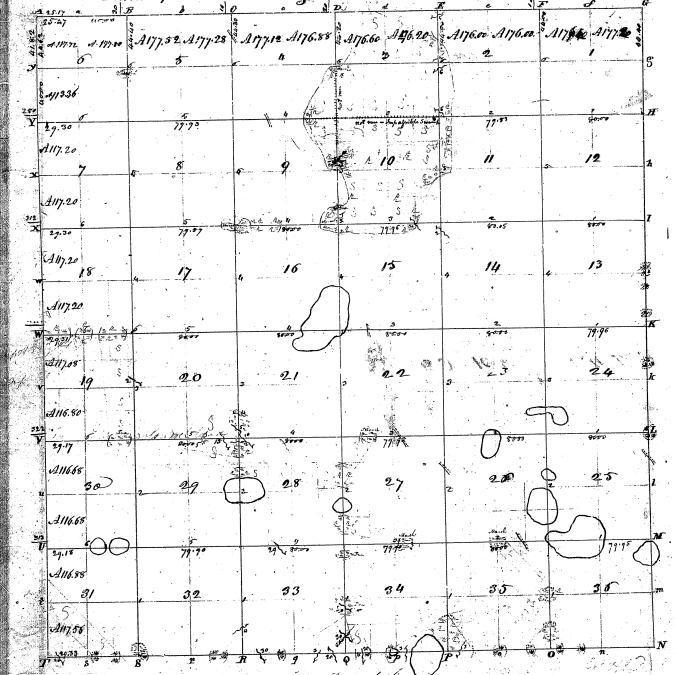

Pursuant to a Contract with and Instruction from Edward Tiffin Esquire Surveyor General of the United States having date the day of I have admeasured laid out and Surveyed the above described Township and do hereby certify that it had such Marks and bounds both natural and artificial as are represented on said plat and described in the field notes made thereof and returned with this plat into the Surveyor Generals Office Certified this 3 day of Dec 1818

Hample D.S.

27-23

27-23