T. 51 N. R. 37 W. | Resurvey | T. 51 N. R. 36 W.

Township No. 50 N. Range No. 37 W. Mer. Mich

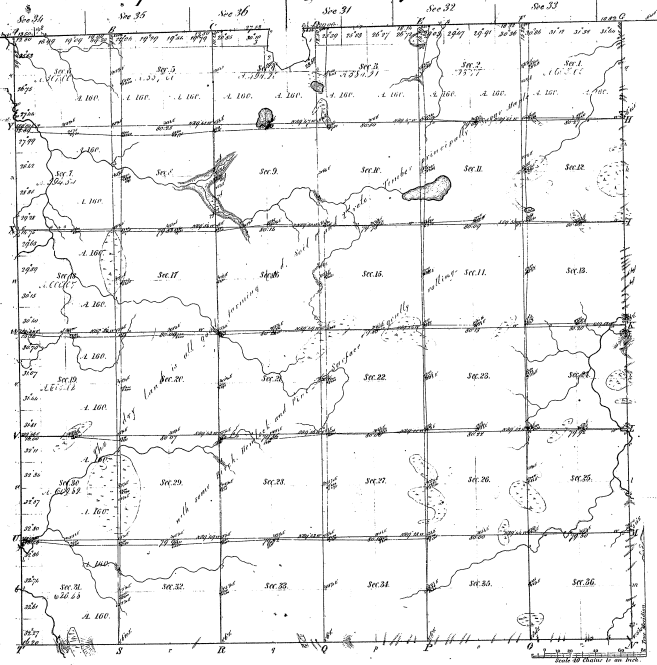

Meanders of							
Feet	Courses	Ch.s Lk.s	Feet	Courses	Ch.s Lk.s	Feet	Courses	Ch.s Lk.s

43-4

43-4

Total number of Acres 22376.77

Surveys Designated.	By Whom Surveyed	Date of Contract	Amount of Surveys	When Surveyed	When p.d for and ch.d in the Surv. Gen.l acc.t
Township lines	Wm. A. & Andw. Burt	April 27. 1857	36 / 44 / 64 / 66	2nd Quar. 1857	
Subdivisions	A. Herryweather	Bond Dec. 31st 1852	60 / 29 / 33	4th Quar. 1852	

The above Map of Township No. 50 North of Range No. 37 West of the Principal Meridian Michigan is strictly conformable to the field notes of the survey thereof on file in this Office which have been examined and approved.

Surveyor General's Office
Detroit Sept. 1st 1853

Leander Chapman
Sur. Gen.l