Township No. 52 N. Range No. 37 W. Mer. Mich.

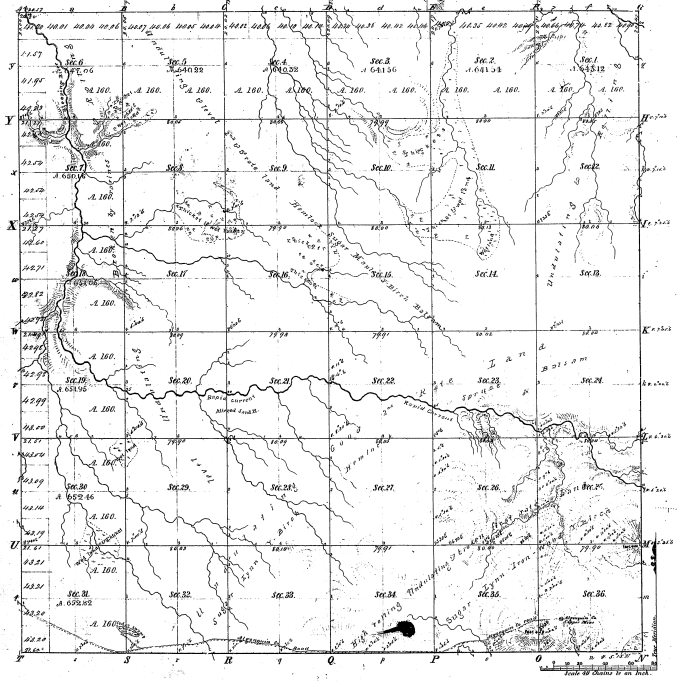

Meanders of								
Posts	Courses	Ch.s Lk.s	Posts	Courses	Ch.s Lk.s	Posts	Courses	Ch.s Lk.s
41-26								

41-26

Total number of Acres 23,112.27

Surveys Designated	By Whom Surveyed	Date of Contract	Amount of Surveys	When Surveyed	When pd. for and ch.d in the Surv.r Gen.l's acct
Township lines	Wm. A. Burnett	June 25th 1846	M. Ch.s Lk.s 72. 02. 47	3d qr. 1846	
Subdivisions	Eggins & Wallace	April 25. 1846	Ch. 08. 19	3 qr. 1846	

The above Map of Township No. 52 North of Range No. 37 West of the Principal Meridian Michigan is strictly conformable to the field notes of the survey thereof on file in this Office, which have been examined and approved.

Surveyor General's Office.
~~Cincinnati~~
Detroit Octr. 16. 1847

Lucius Lyon, Surv.r Gen.l